

LEGEND

UNIQUE PARCEL IDENTITY NUMBER	MAP No.	BLOCK No.	PARCEL No.
	076	02	02
			076-01-001

076 REFERENCE TO ADJOINING MAP
02 REFERENCE TO BLOCK NUMBER
02 REFERENCE TO PARCEL NUMBER

E-911 LEGEND

	BUILDING FOOTPRINTS	4-2005
	ROAD CARTWAY	4-2005
	PARKING AREA	4-2005

Provided by: E911 Numbers Board, Spring 2005 Flight.

RED ANNOTATION MAY NOT BE UPDATED IN THE GIS MASTER DATABASES PLEASE VERIFY WITH THE ENGINEERING DEPT. ANY ITEM IN RED

NOTES: Digital Base - FSU
2006 Digital photo Base - update
House number Files - redlines transferred
2005 E911 Planimetry - Houses and pavement
Added legal parcel lines - per recorded plats

CITY OF HAGERSTOWN, MARYLAND
ENGINEERING DEPARTMENT

LOCATION City of Hagerstown


TITLE
TAX MAP 11

DRAWN BY	T.Williams	DATE	01-13-02
Revision	T.Williams	DATE	08-15-11

SCALES	HORIZ.: 1" = 100'	VERTICAL:
APPROVED	FILE NUMBER	

DATE	80-002-11
BY	

CITY ENGINEER

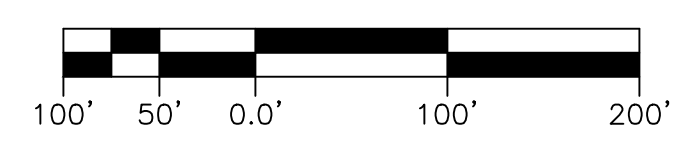

All parcels are shown as they appear in the 2005 E911 Planimetry. Any change in parcel boundaries or building footprints since the 2005 E911 Planimetry is shown in red.