



E-911 LEGEND	
	BUILDING FOOTPRINTS 4-2005
	ROAD CARTWAY 4-2005
	PARKING AREA 4-2005
Provided by: E911 Numbers Board, Spring 2005 Flight.	

LEGEND	
	UNIQUE PARCEL IDENTITY NUMBER
	MAP No. 076-01-001
	BLOCK No.
	PARCEL No.
	REFERENCE TO ADJOINING MAP
	REFERENCE TO BLOCK NUMBER
	REFERENCE TO PARCEL NUMBER

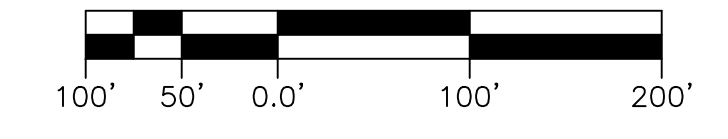

RED ANNOTATION MAY NOT BE UPDATED
IN THE GIS MASTER DATABASES
PLEASE VERIFY WITH THE ENGINEERING DEPT.
ANY ITEM IN RED

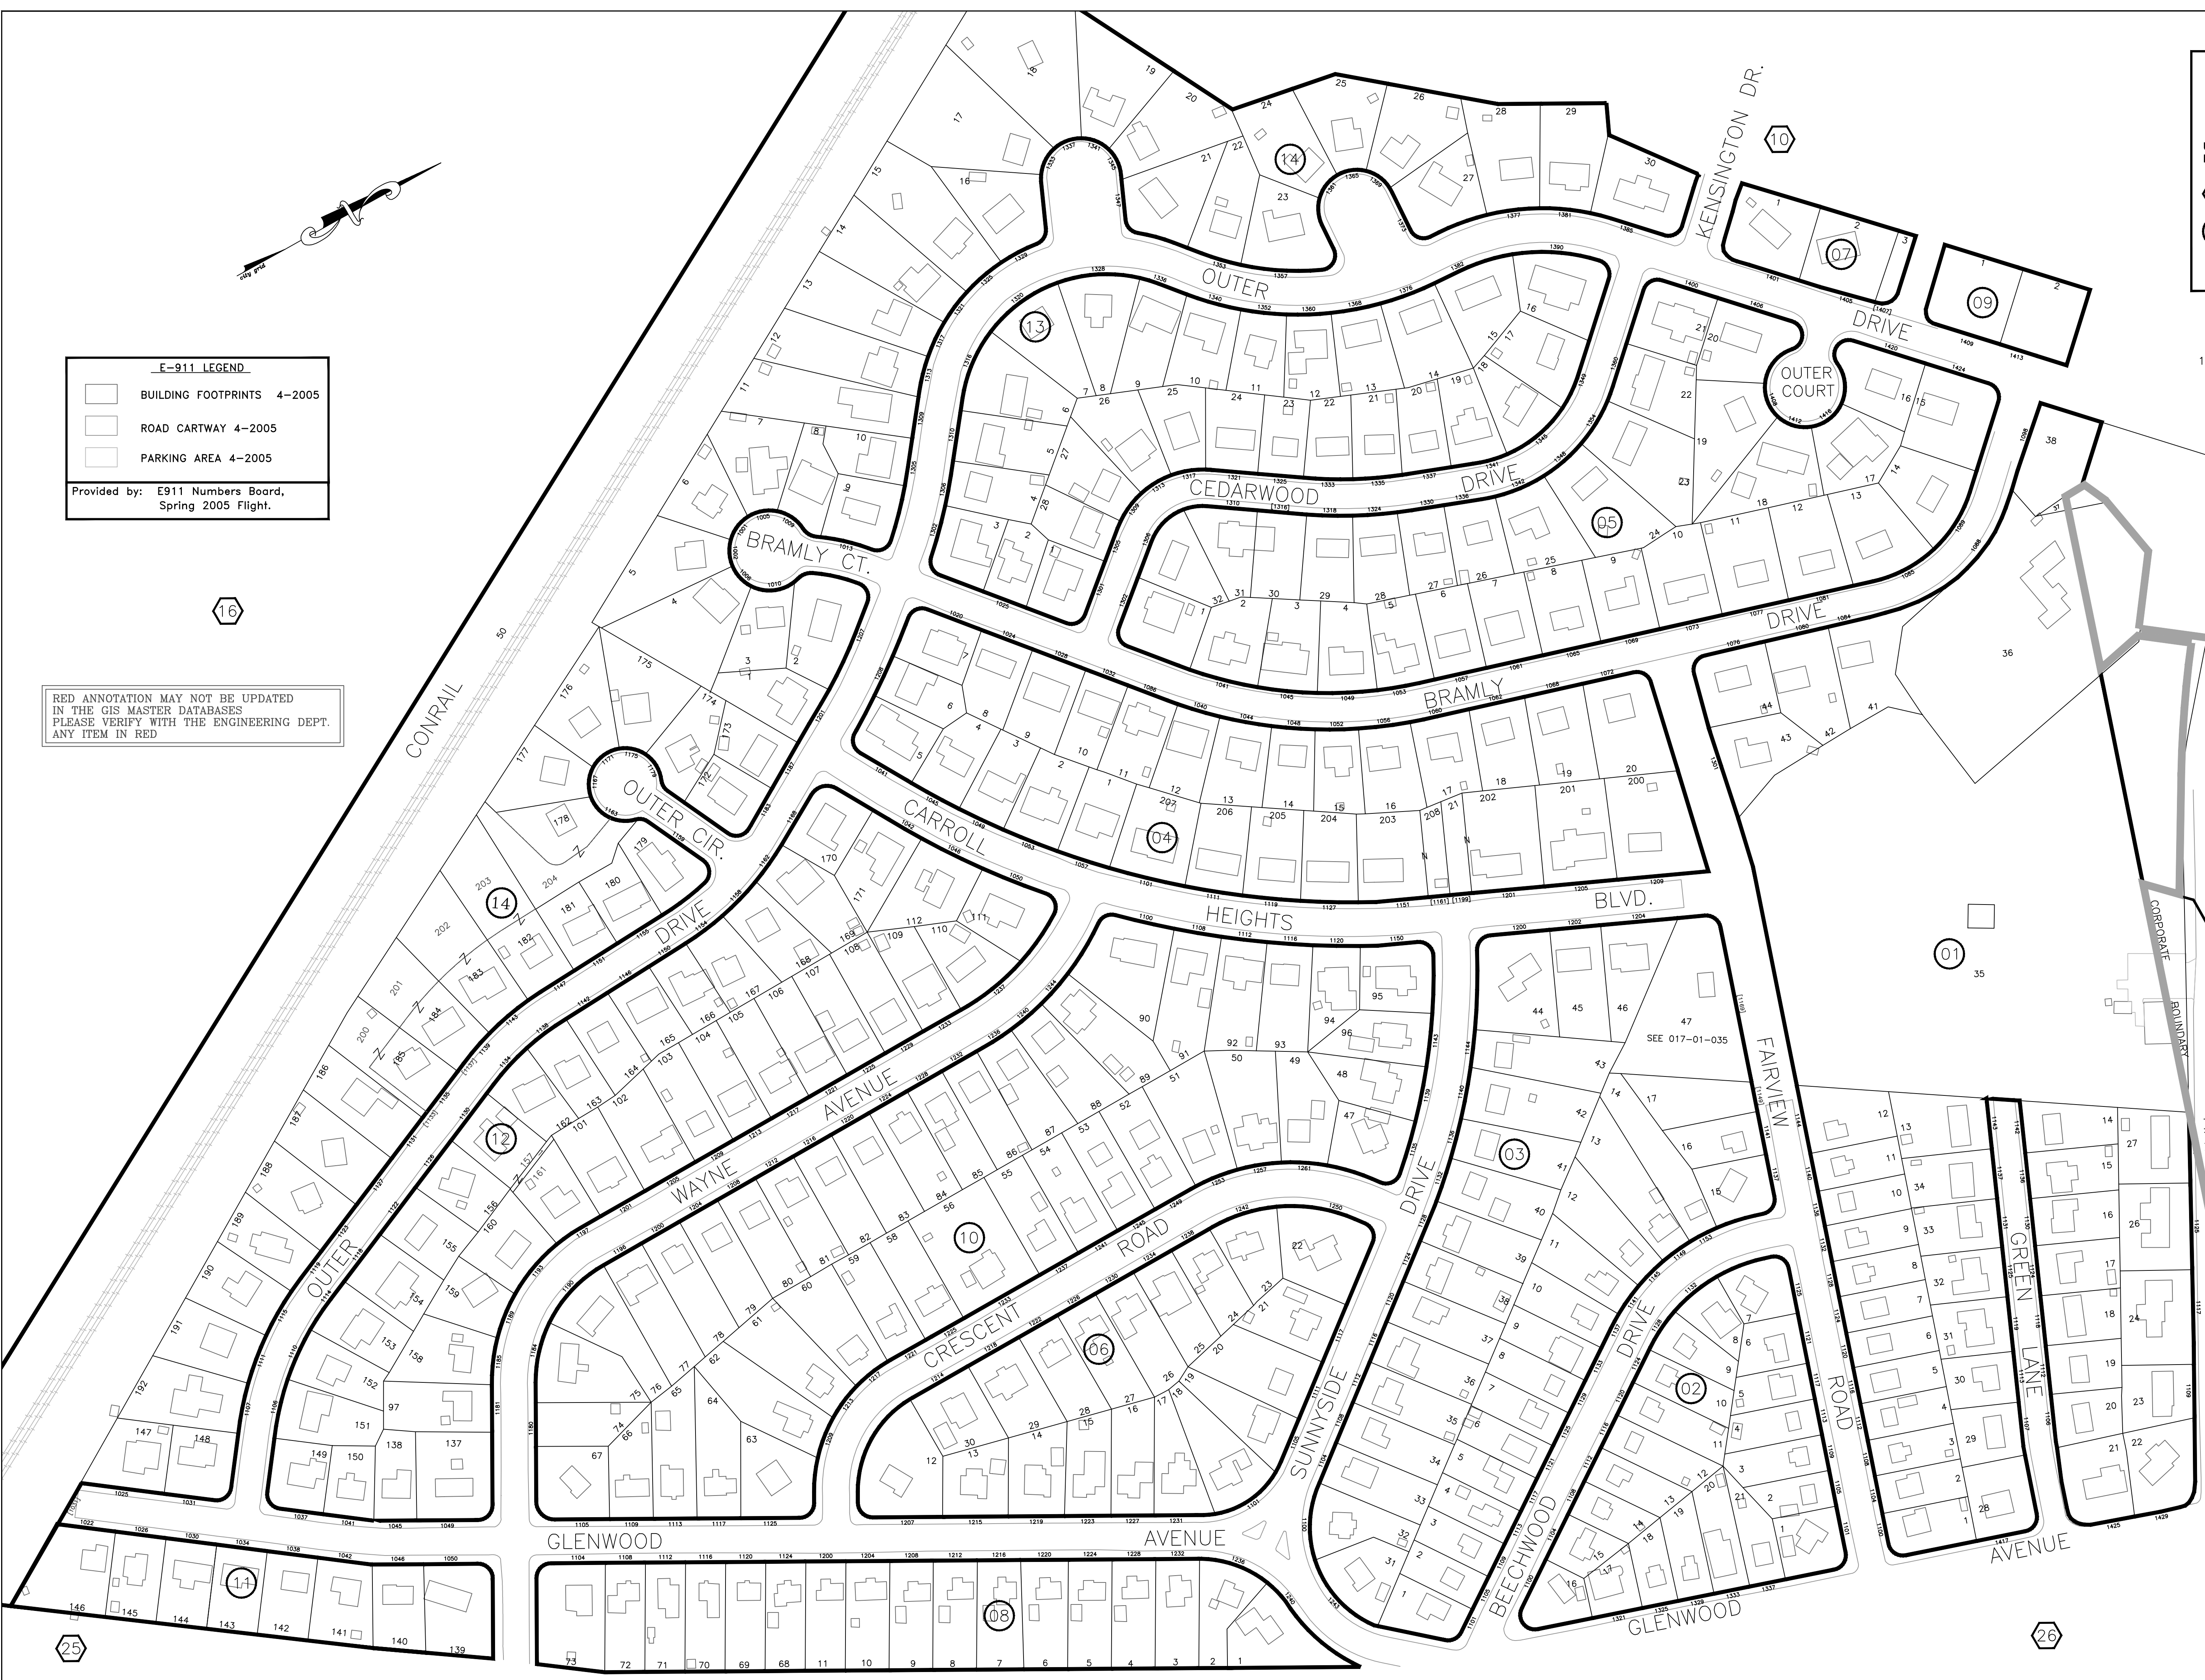

NOTES: Digital Base - FSU
2006 Digital photo Base - update
House number Files - redlines transferred
2005 E911 Planimetry - Houses and pavement
Added legal parcel lines - per recorded plans

CITY OF HAGERSTOWN, MARYLAND ENGINEERING DEPARTMENT	
LOCATION City of Hagerstown	
TITLE TAX MAP 17	
DRAWN BY T. Williams	DATE 06-28-02
Revision N. McKenny	DATE 11-20-08
SCALES HORIZ: 1" = 100'	VERTICAL:
APPROVED	FILE NUMBER
DATE	80-002-17
BY CITY ENGINEER	