


E-911 LEGEND	
	BUILDING FOOTPRINTS 4-2005
	ROAD CARTWAY 4-2005
	PARKING AREA 4-2005

Provided by: E911 Numbers Board,
Spring 2005 Flight.

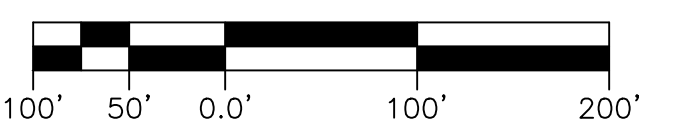

LEGEND		
UNIQUE PARCEL IDENTITY NUMBER	MAP No.	BLOCK No.
	076-01	001
	REFERENCE TO ADJOINING MAP	
	REFERENCE TO BLOCK NUMBER	
02	REFERENCE TO PARCEL NUMBER	

NOTES: Digital Base - FSJ
2006 Digital photo Base - update
House number Files - redlines transferred
2005 E911 Planimetry - Houses and pavement
Added legal parcel lines - per recorded plats

CITY OF HAGERSTOWN, MARYLAND
ENGINEERING DEPARTMENT

LOCATION City of Hagerstown

TITLE
TAX MAP 70

DRAWN BY T. Williams DATE 12-04-03

Revision N. McKenny DATE 09-05-08

SCALES HORIZ.: 1" = 100' VERTICAL:

APPROVED FILE NUMBER

DATE 80-002-70

BY CITY ENGINEER

RED ANNOTATION MAY NOT BE UPDATED
IN THE GIS MASTER DATABASES
PLEASE VERIFY WITH THE ENGINEERING DEPT.
ANY ITEM IN RED

A:\DWG\02-09-03\02-09-03\02-09-03.dwg Feb 11, 2011 11:58am User: hwilliams