


E-911 LEGEND

- BUILDING FOOTPRINTS 4-2005
- ROAD CARTWAY 4-2005
- PARKING AREA 4-2005


Provided by: E911 Numbers Board,
Spring 2005 Flight.

LEGEND

UNIQUE PARCEL IDENTITY NUMBER	MAP No. 076-01-001	BLOCK No.	PARCEL No.
76	REFERENCE TO ADJOINING MAP		
02	REFERENCE TO BLOCK NUMBER		
02	REFERENCE TO PARCEL NUMBER		

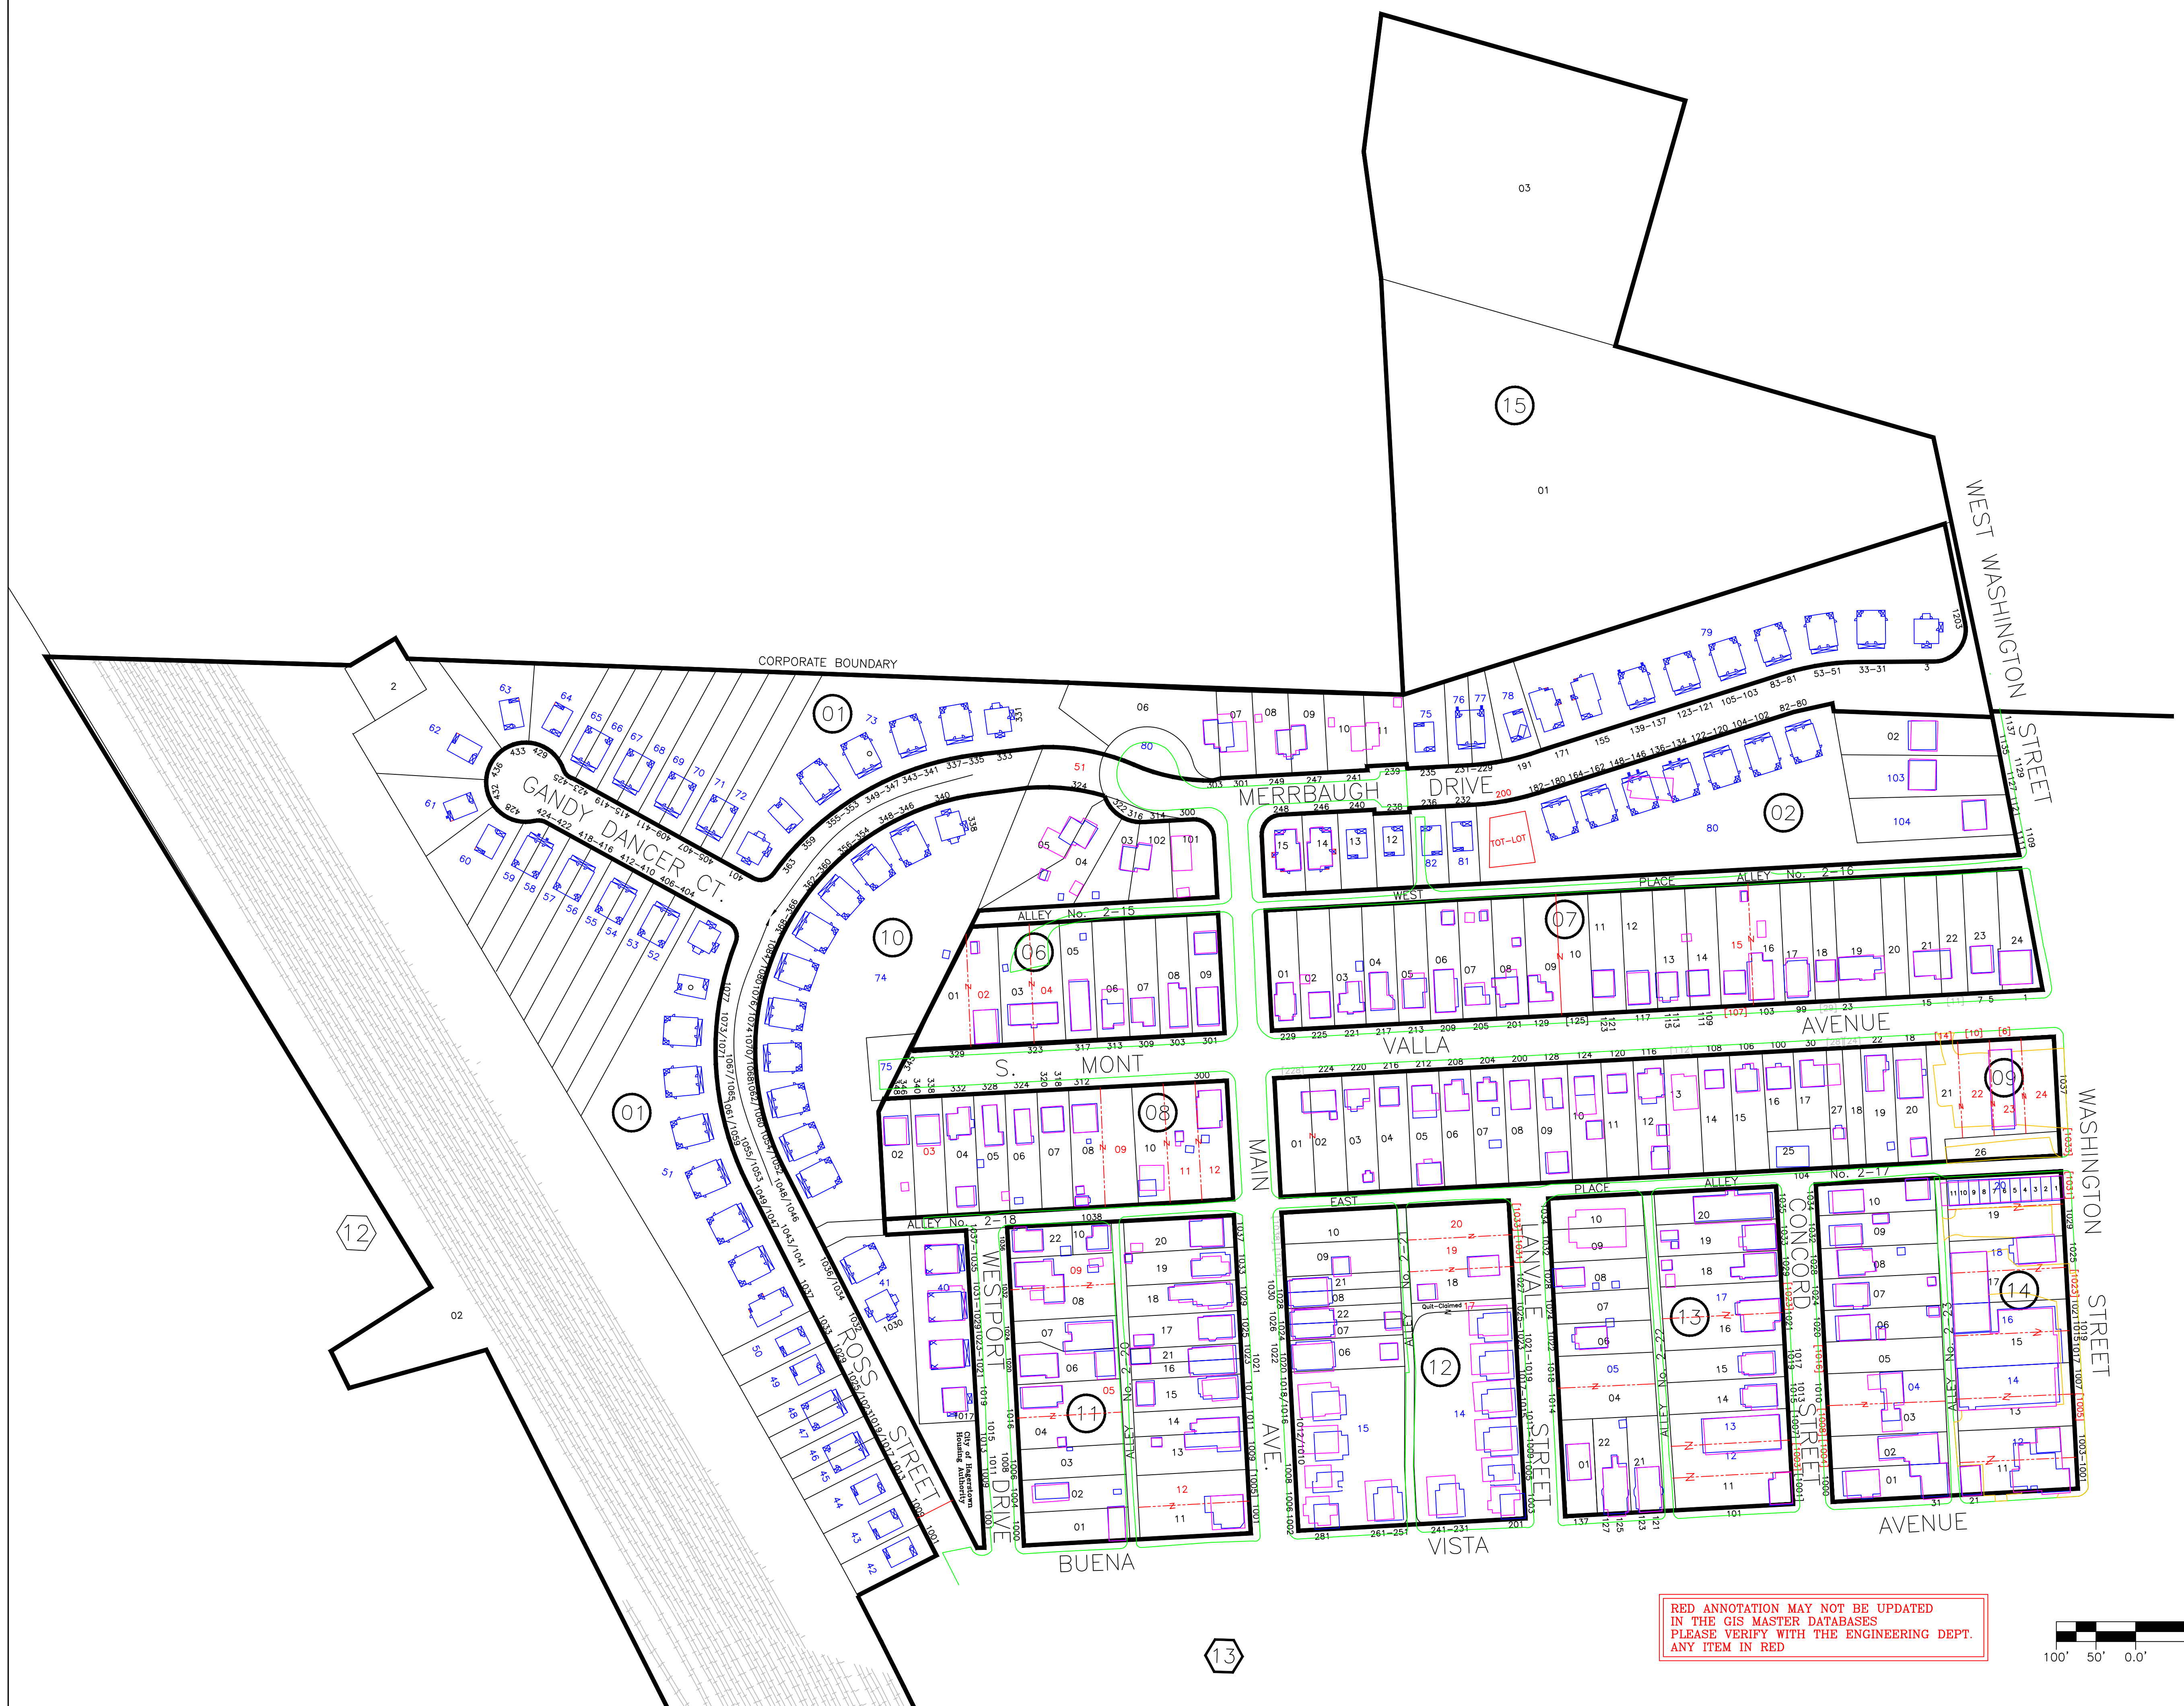

RED ANNOTATION MAY NOT BE UPDATED
IN THE GIS MASTER DATABASES
PLEASE VERIFY WITH THE ENGINEERING DEPT.
ANY ITEM IN RED

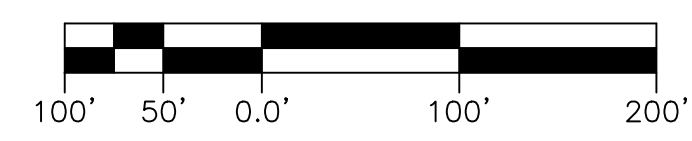

NOTES: Digital Base - FSU
2006 Digital photo Base - update
House number Files - redlines transferred
2005 E911 Planimetry - Houses and pavement
Added legal parcel lines - per recorded plats

CITY OF HAGERSTOWN, MARYLAND ENGINEERING DEPARTMENT			
LOCATION City of Hagerstown			
TITLE TAX MAP 4			
DRAWN BY	T.Williams	DATE	12-20-01
Revision	T.Williams	DATE	08-16-11
SCALES	HORIZ.: 1" = 100'	VERTICAL:	
APPROVED		FILE NUMBER	
DATE		80-002-04	
BY	CITY ENGINEER		

K:\DWG\100-001-001-002\Draw\10002004.dwg Aug 16, 2011 - 4:07pm User: twilliams