
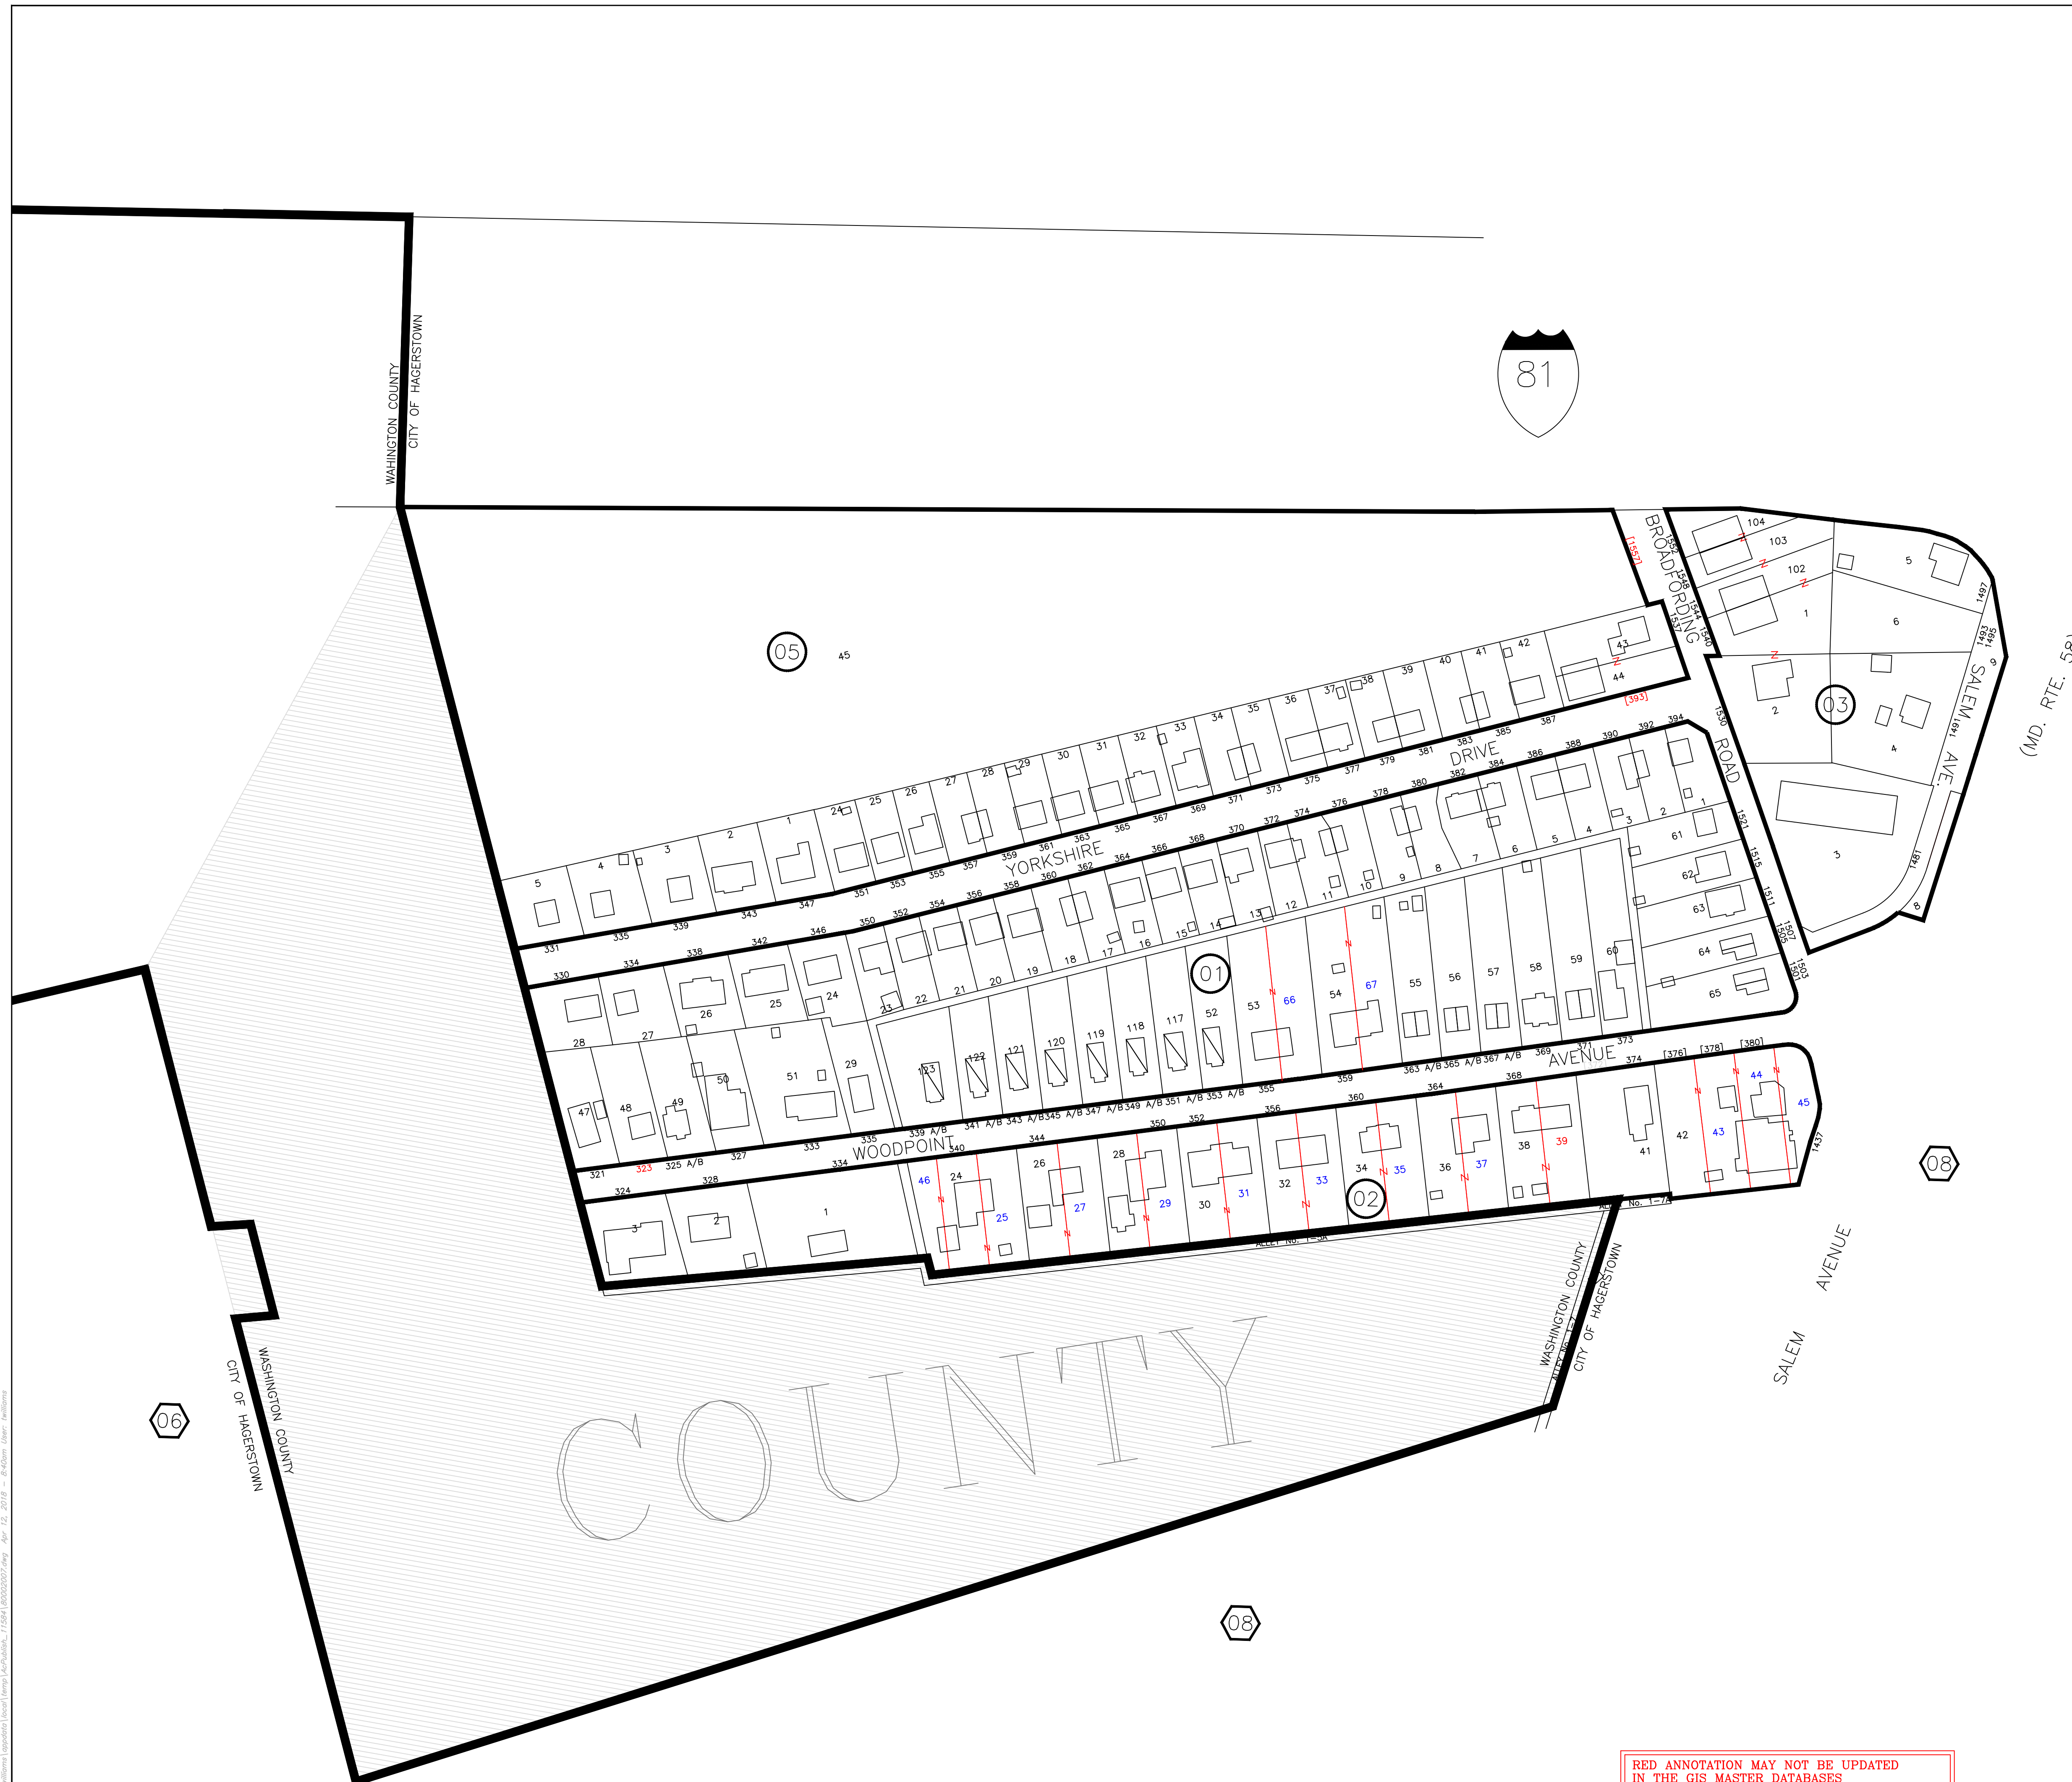


LEGEND	
UNIQUE PARCEL IDENTITY NUMBER	MAP No. BLOCK No. PARCEL No. 076-01-001
	REFERENCE TO ADJOINING MAP
	REFERENCE TO BLOCK NUMBER
02	REFERENCE TO PARCEL NUMBER

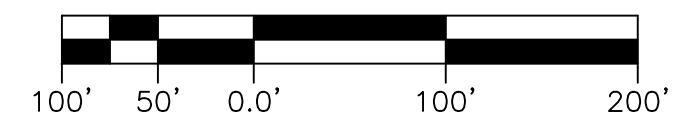

COUNTY

RED ANNOTATION MAY NOT BE UPDATED  
IN THE GIS MASTER DATABASES  
PLEASE VERIFY WITH THE ENGINEERING DEPT.  
ANY ITEM IN RED

NOTES: Digital Base - FSJ 2006 Digital photo Base - update House number Files -redlines transferred 2005 E911 Planimetry - Houses and pavement Added legal parcel lines - per recorded plats			
CITY OF HAGERSTOWN, MARYLAND ENGINEERING DEPARTMENT			
LOCATION City of Hagerstown			
TITLE TAX MAP 7			
DRAWN BY	T.Williams	DATE	01-28-02
Revision	T.Williams	DATE	03-13-18
SCALES	HORIZ.: 1"= 100'	VERTICAL:	
APPROVED		FILE NUMBER	
DATE		80-002-07	
BY		CITY ENGINEER	

C:\Users\T.Williams\Documents\Projects\Hagerstown\Map\Map\_02\_2018.mxd - 2/2/18 - 10:40am - T.Williams