

LEGEND

UNIQUE PARCEL IDENTITY NUMBER

76 REFERENCE TO ADJOINING MAP


02 REFERENCE TO BLOCK NUMBER

02 REFERENCE TO PARCEL NUMBER

MAP No. 076-01-001

BLOCK No.

PARCEL No.

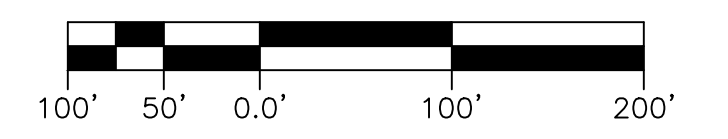

RED ANNOTATION MAY NOT BE UPDATED
IN THE GIS MASTER DATABASES
PLEASE VERIFY WITH THE ENGINEERING DEPT.
ANY ITEM IN RED

NOTES: Digital Base - FSU
2006 Digital photo Base - update
House number Files - redlines transferred
2005 E911 Planimetry - Houses and pavement
Added legal parcel lines - per recorded plats

CITY OF HAGERSTOWN, MARYLAND
ENGINEERING DEPARTMENT

LOCATION City of Hagerstown

TITLE
TAX MAP 15

DRAWN BY	T. Williams	DATE	06-06-02
Revision	T. Williams	DATE	08-22-16
SCALES	HORIZ.: 1" = 100'	VERTICAL:	
APPROVED		FILE NUMBER	
DATE		80-002-15	
BY		CITY ENGINEER	

C:\Users\james\OneDrive\Documents\GIS\Map15\Map15.dwg July 22, 2016 - T. Williams