




Easements

-  Access Easement
-  Forest Conservation Easement
-  Storm Drain Easement
-  Sanitary Easement
-  Utility Easement
-  Waterline Easement

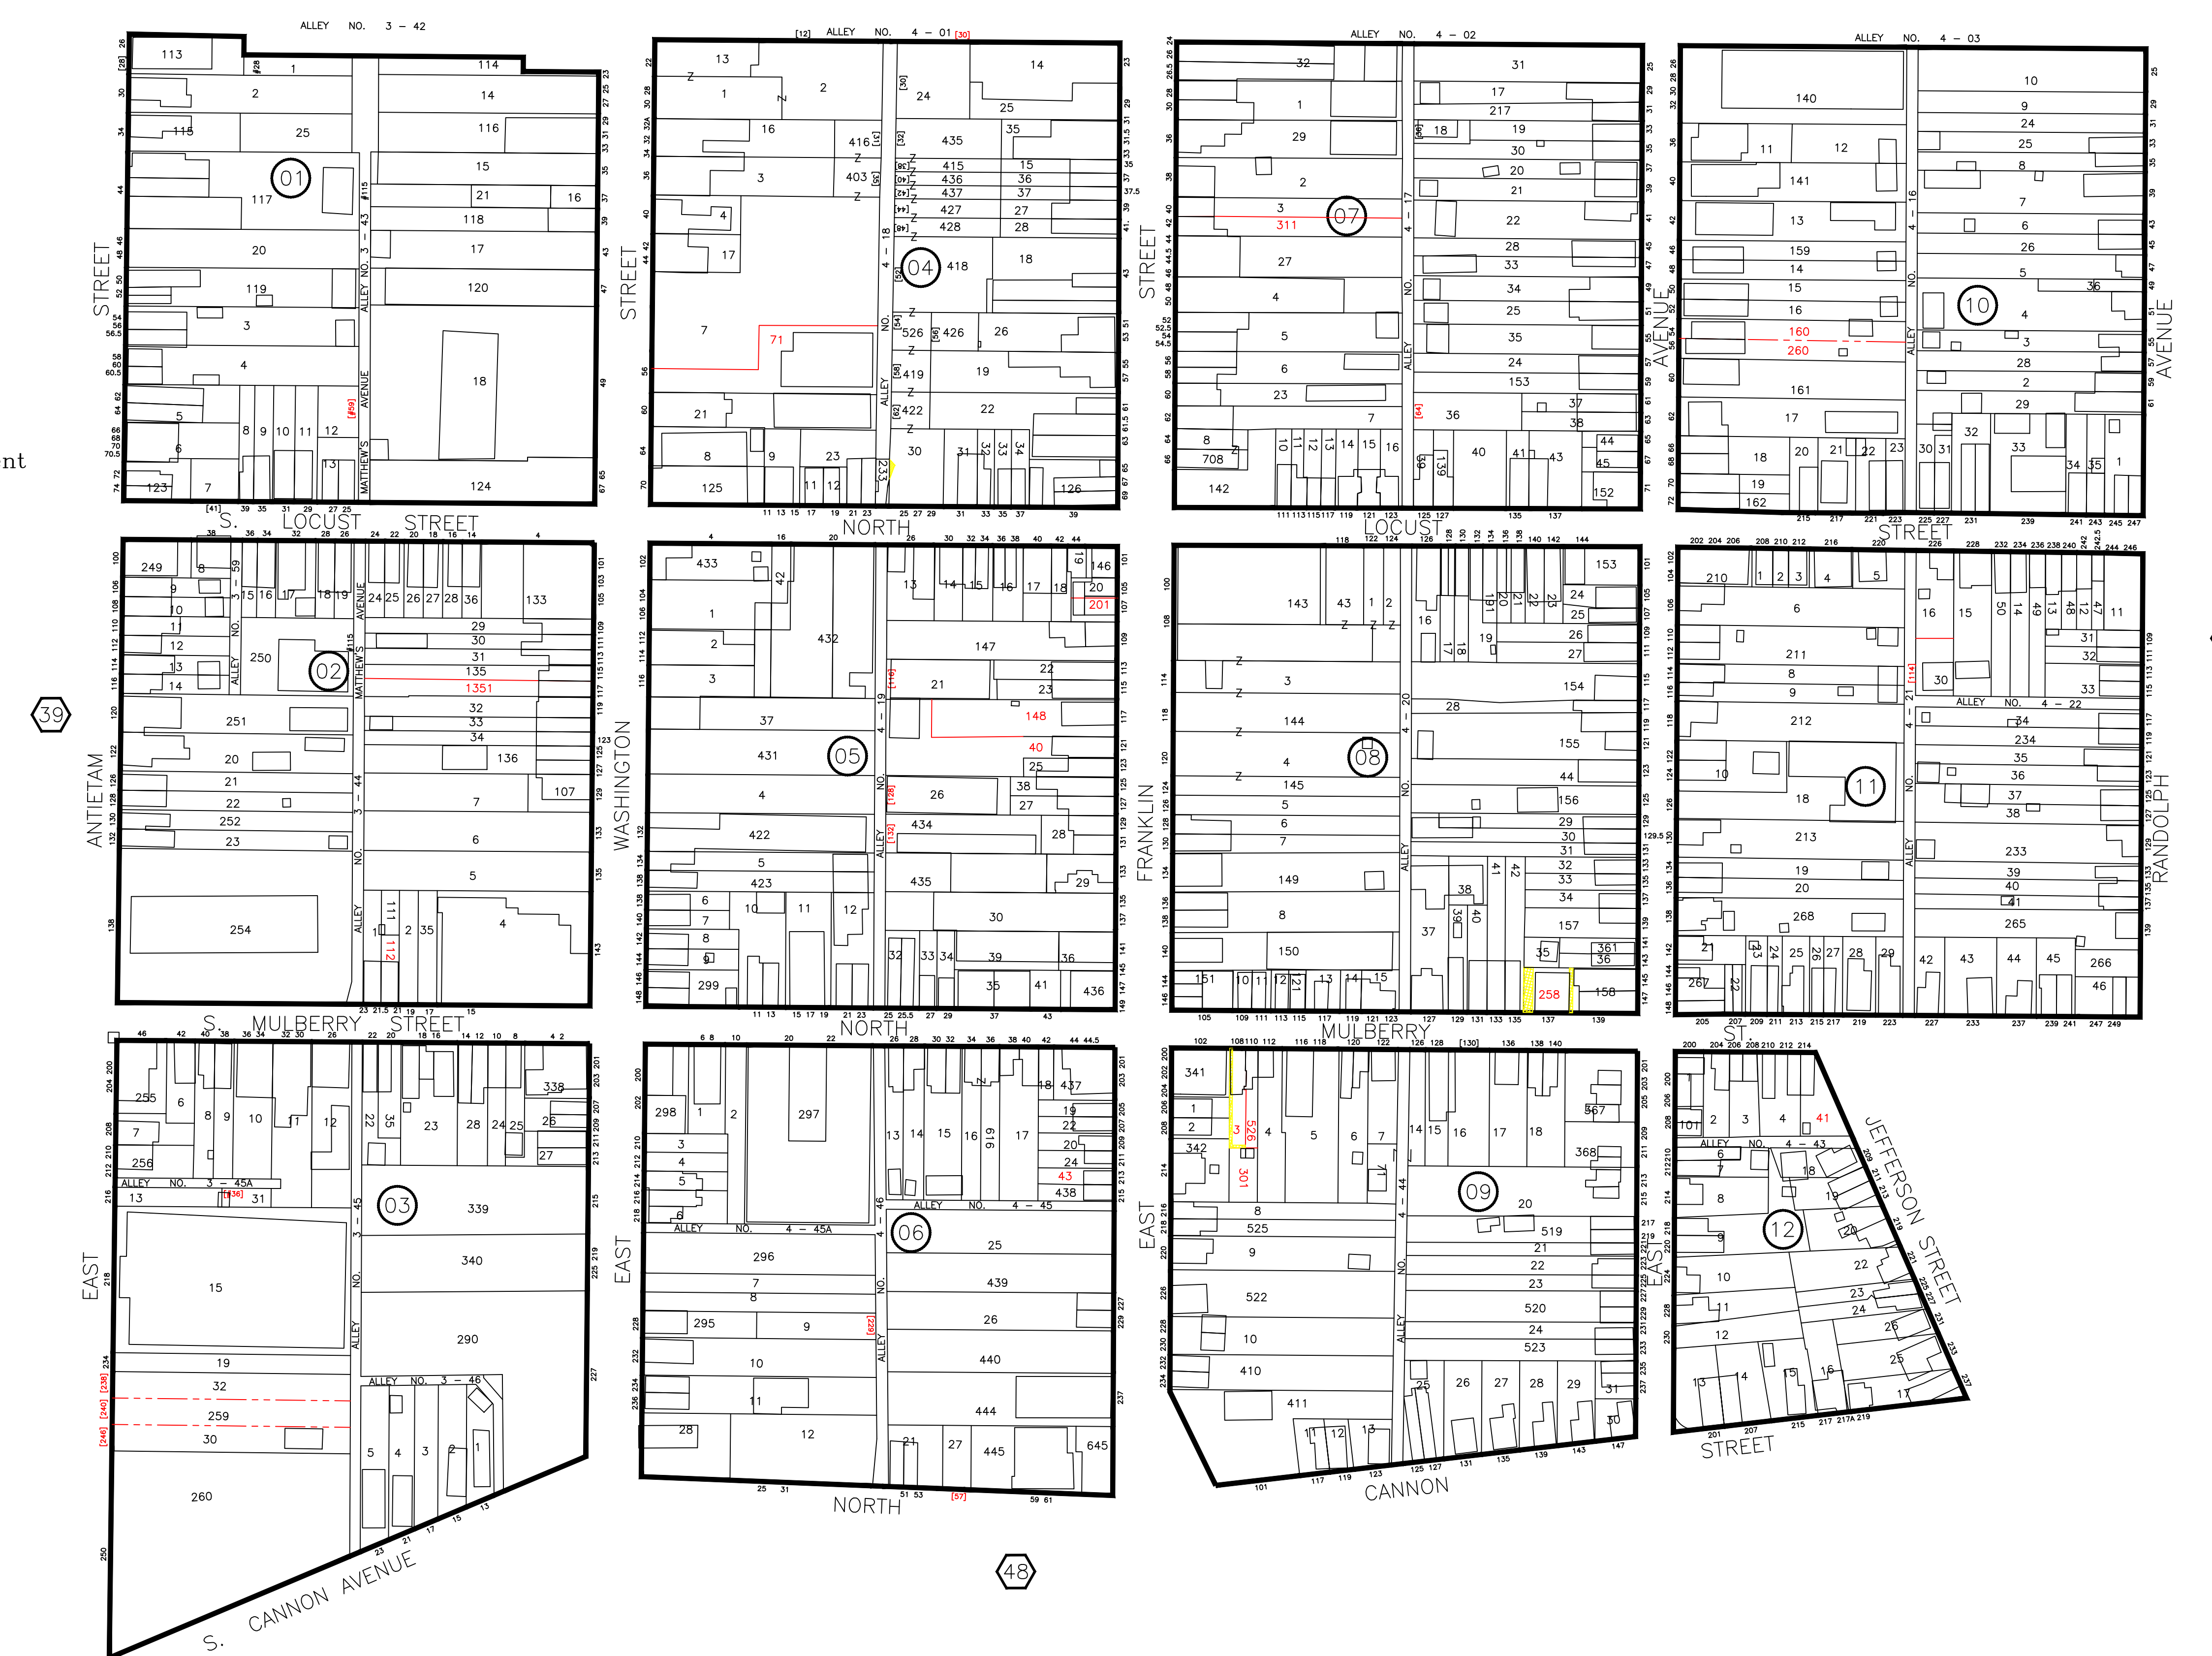

RED ANNOTATION MAY NOT BE UPDATED
 IN THE GIS MASTER DATABASES
 PLEASE VERIFY WITH THE ENGINEERING DEPT.
 ANY ITEM IN RED

LEGEND	
UNIQUE PARCEL IDENTITY NUMBER	MAP No. BLOCK No. PARCEL No. 076-01-001
 REFERENCE TO ADJOINING MAP	
 REFERENCE TO BLOCK NUMBER	
02 REFERENCE TO PARCEL NUMBER	

NOTES: Digital Base - FSU
 2006 Digital photo Base - update
 House number Files -redlines transferred
 2005 E911 Planimetry - Houses and pavement
 Added legal parcel lines - per recorded plats

CITY OF HAGERSTOWN, MARYLAND
 ENGINEERING DEPARTMENT

LOCATION City of Hagerstown

TITLE TAX MAP 40

DRAWN BY T.Williams DATE 01-21-2003

Revision T.Williams DATE 05-09-2019

SCALES | HORIZ.: 1"= 100' | VERTICAL:

APPROVED FILE NUMBER

DATE 80-002-40

BY CITY ENGINEER