

E-911 LEGEND	
	BUILDING FOOTPRINTS 4-2005
	ROAD CARTWAY 4-2005
	PARKING AREA 4-2005


Provided by: E911 Numbers Board,
Spring 2005 Flight.

LEGEND	
UNIQUE PARCEL IDENTITY NUMBER	MAP No. BLOCK No. PARCEL No. 076-01-001
	REFERENCE TO ADJOINING MAP
	REFERENCE TO BLOCK NUMBER
02	REFERENCE TO PARCEL NUMBER

NOTES: Digital Base - FSJ
2006 Digital photo Base - update
House number Files - redlines transferred
2005 E911 Planimetry - Houses and pavement
Added legal parcel lines - per recorded plats

CITY OF HAGERSTOWN, MARYLAND ENGINEERING DEPARTMENT	
LOCATION City of Hagerstown	
TITLE TAX MAP 44	
DRAWN BY T.Williams	DATE 04-01-03
Revision N. McKenny	DATE 11-07-08
SCALES HORIZ.: 1"= 100'	VERTICAL:
APPROVED	FILE NUMBER
DATE	80-002-44
BY _____ CITY ENGINEER	

RED ANNOTATION MAY NOT BE UPDATED
IN THE GIS MASTER DATABASES
PLEASE VERIFY WITH THE ENGINEERING DEPT.
ANY ITEM IN RED

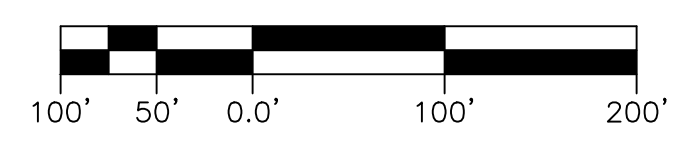

\\\gms21\gis\mxd\076-01-001\076-01-001-001.dwg Date: 11/07/08 Time: 12:42pm User: bwilliams