

E-911 LEGEND

- BUILDING FOOTPRINTS 4-2005
- ROAD CARTWAY 4-2005
- PARKING AREA 4-2005


Provided by: E911 Numbers Board,
Spring 2005 Flight.

LEGEND

UNIQUE PARCEL IDENTITY NUMBER

REFERENCE TO ADJOINING MAP
 REFERENCE TO BLOCK NUMBER
 02 REFERENCE TO PARCEL NUMBER

MAP No. 076-01-001
 BLOCK No.
 PARCEL No.

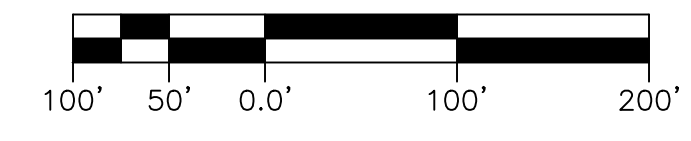

RED ANNOTATION MAY NOT BE UPDATED IN THE GIS MASTER DATABASES. PLEASE VERIFY WITH THE ENGINEERING DEPT. ANY ITEM IN RED

NOTES: Digital Base - FSU
2006 Digital photo Base - update
House number Files - redlines transferred
2005 E911 Planimetry - Houses and pavement
Added legal parcel lines - per recorded plots

**CITY OF HAGERSTOWN, MARYLAND
ENGINEERING DEPARTMENT**

LOCATION City of Hagerstown

TITLE **TAX MAP 54**

DRAWN BY T.Williams	DATE 05-15-03
Revision N. McKenny	DATE 09-18-08
SCALES HORIZ.: 1"= 100'	VERTICAL:
APPROVED	FILE NUMBER
DATE	80-002-54
BY CITY ENGINEER	

M:\Projects\09-18-08\08-002\Draws\08002004.dwg File 11, 2017 - 10:50am User: ashburn