


RED ANNOTATION MAY NOT BE UPDATED
IN THE GIS MASTER DATABASES
PLEASE VERIFY WITH THE ENGINEERING DEPT.
ANY ITEM IN RED

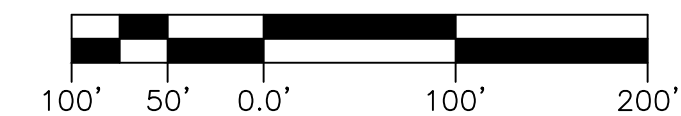

LEGEND

UNIQUE PARCEL IDENTITY NUMBER	[] MAP No. [] BLOCK No. [] PARCEL No.
[76]	REFERENCE TO ADJOINING MAP
[02]	REFERENCE TO BLOCK NUMBER
02	REFERENCE TO PARCEL NUMBER

NOTES: Digital Base - FSU
2006 Digital photo Base - update
House number Files - redlines transferred
2005 E911 Planimetry - Houses and pavement
Added legal parcel lines - per recorded plats

**CITY OF HAGERSTOWN, MARYLAND
ENGINEERING DEPARTMENT**

LOCATION City of Hagerstown

TITLE
TAX MAP 56

DRAWN BY T.Williams	DATE 07-31-03	
Revision T.Williams	DATE 07-09-14	
SCALES HORIZ.: 1" = 100'		VERTICAL:
APPROVED	FILE NUMBER	
DATE	80-002-56	
BY _____	CITY ENGINEER	