


**E-911 LEGEND**

	BUILDING FOOTPRINTS 4-2005
	ROAD CARTWAY 4-2005
	PARKING AREA 4-2005

Provided by: E911 Numbers Board,  
Spring 2005 Flight.

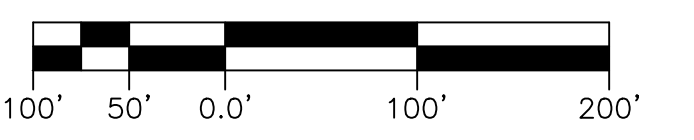

**LEGEND**

UNIQUE PARCEL IDENTITY NUMBER	MAP No. 076-01-001	BLOCK No.	PARCEL No.
	REFERENCE TO ADJOINING MAP		REFERENCE TO BLOCK NUMBER
02	REFERENCE TO PARCEL NUMBER		

NOTES: Digital Base - FSU  
2006 Digital photo Base - update  
House number Files - redlines transferred  
2005 E911 Planimetry - Houses and pavement  
Added legal parcel lines - per recorded plats

CITY OF HAGERSTOWN, MARYLAND  
ENGINEERING DEPARTMENT

LOCATION City of Hagerstown

TITLE  
**TAX MAP 70**

DRAWN BY T. Williams DATE 12-04-03

Revision N. McKenny DATE 09-05-08

SCALES HORIZ.: 1" = 100' VERTICAL:

APPROVED FILE NUMBER

DATE 80-002-70

BY CITY ENGINEER

RED ANNOTATION MAY NOT BE UPDATED  
IN THE GIS MASTER DATABASES  
PLEASE VERIFY WITH THE ENGINEERING DEPT.  
ANY ITEM IN RED

A:\PROJECTS\09-001\09-001\09-001\09-001\09-001\09-001.dwg Feb 11, 2011 11:58am User: hwilliams