

RED ANNOTATION MAY NOT BE UPDATED  
 IN THE GIS MASTER DATABASES  
 PLEASE VERIFY WITH THE ENGINEERING DEPT.  
 ANY ITEM IN RED

**LEGEND**

UNIQUE PARCEL IDENTITY NUMBER

76 REFERENCE TO ADJOINING MAP



02 REFERENCE TO BLOCK NUMBER

02 REFERENCE TO PARCEL NUMBER

MAP No. 076-01-001

BLOCK No.

PARCEL No.

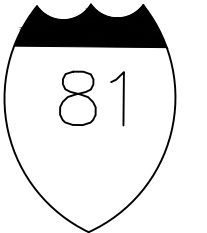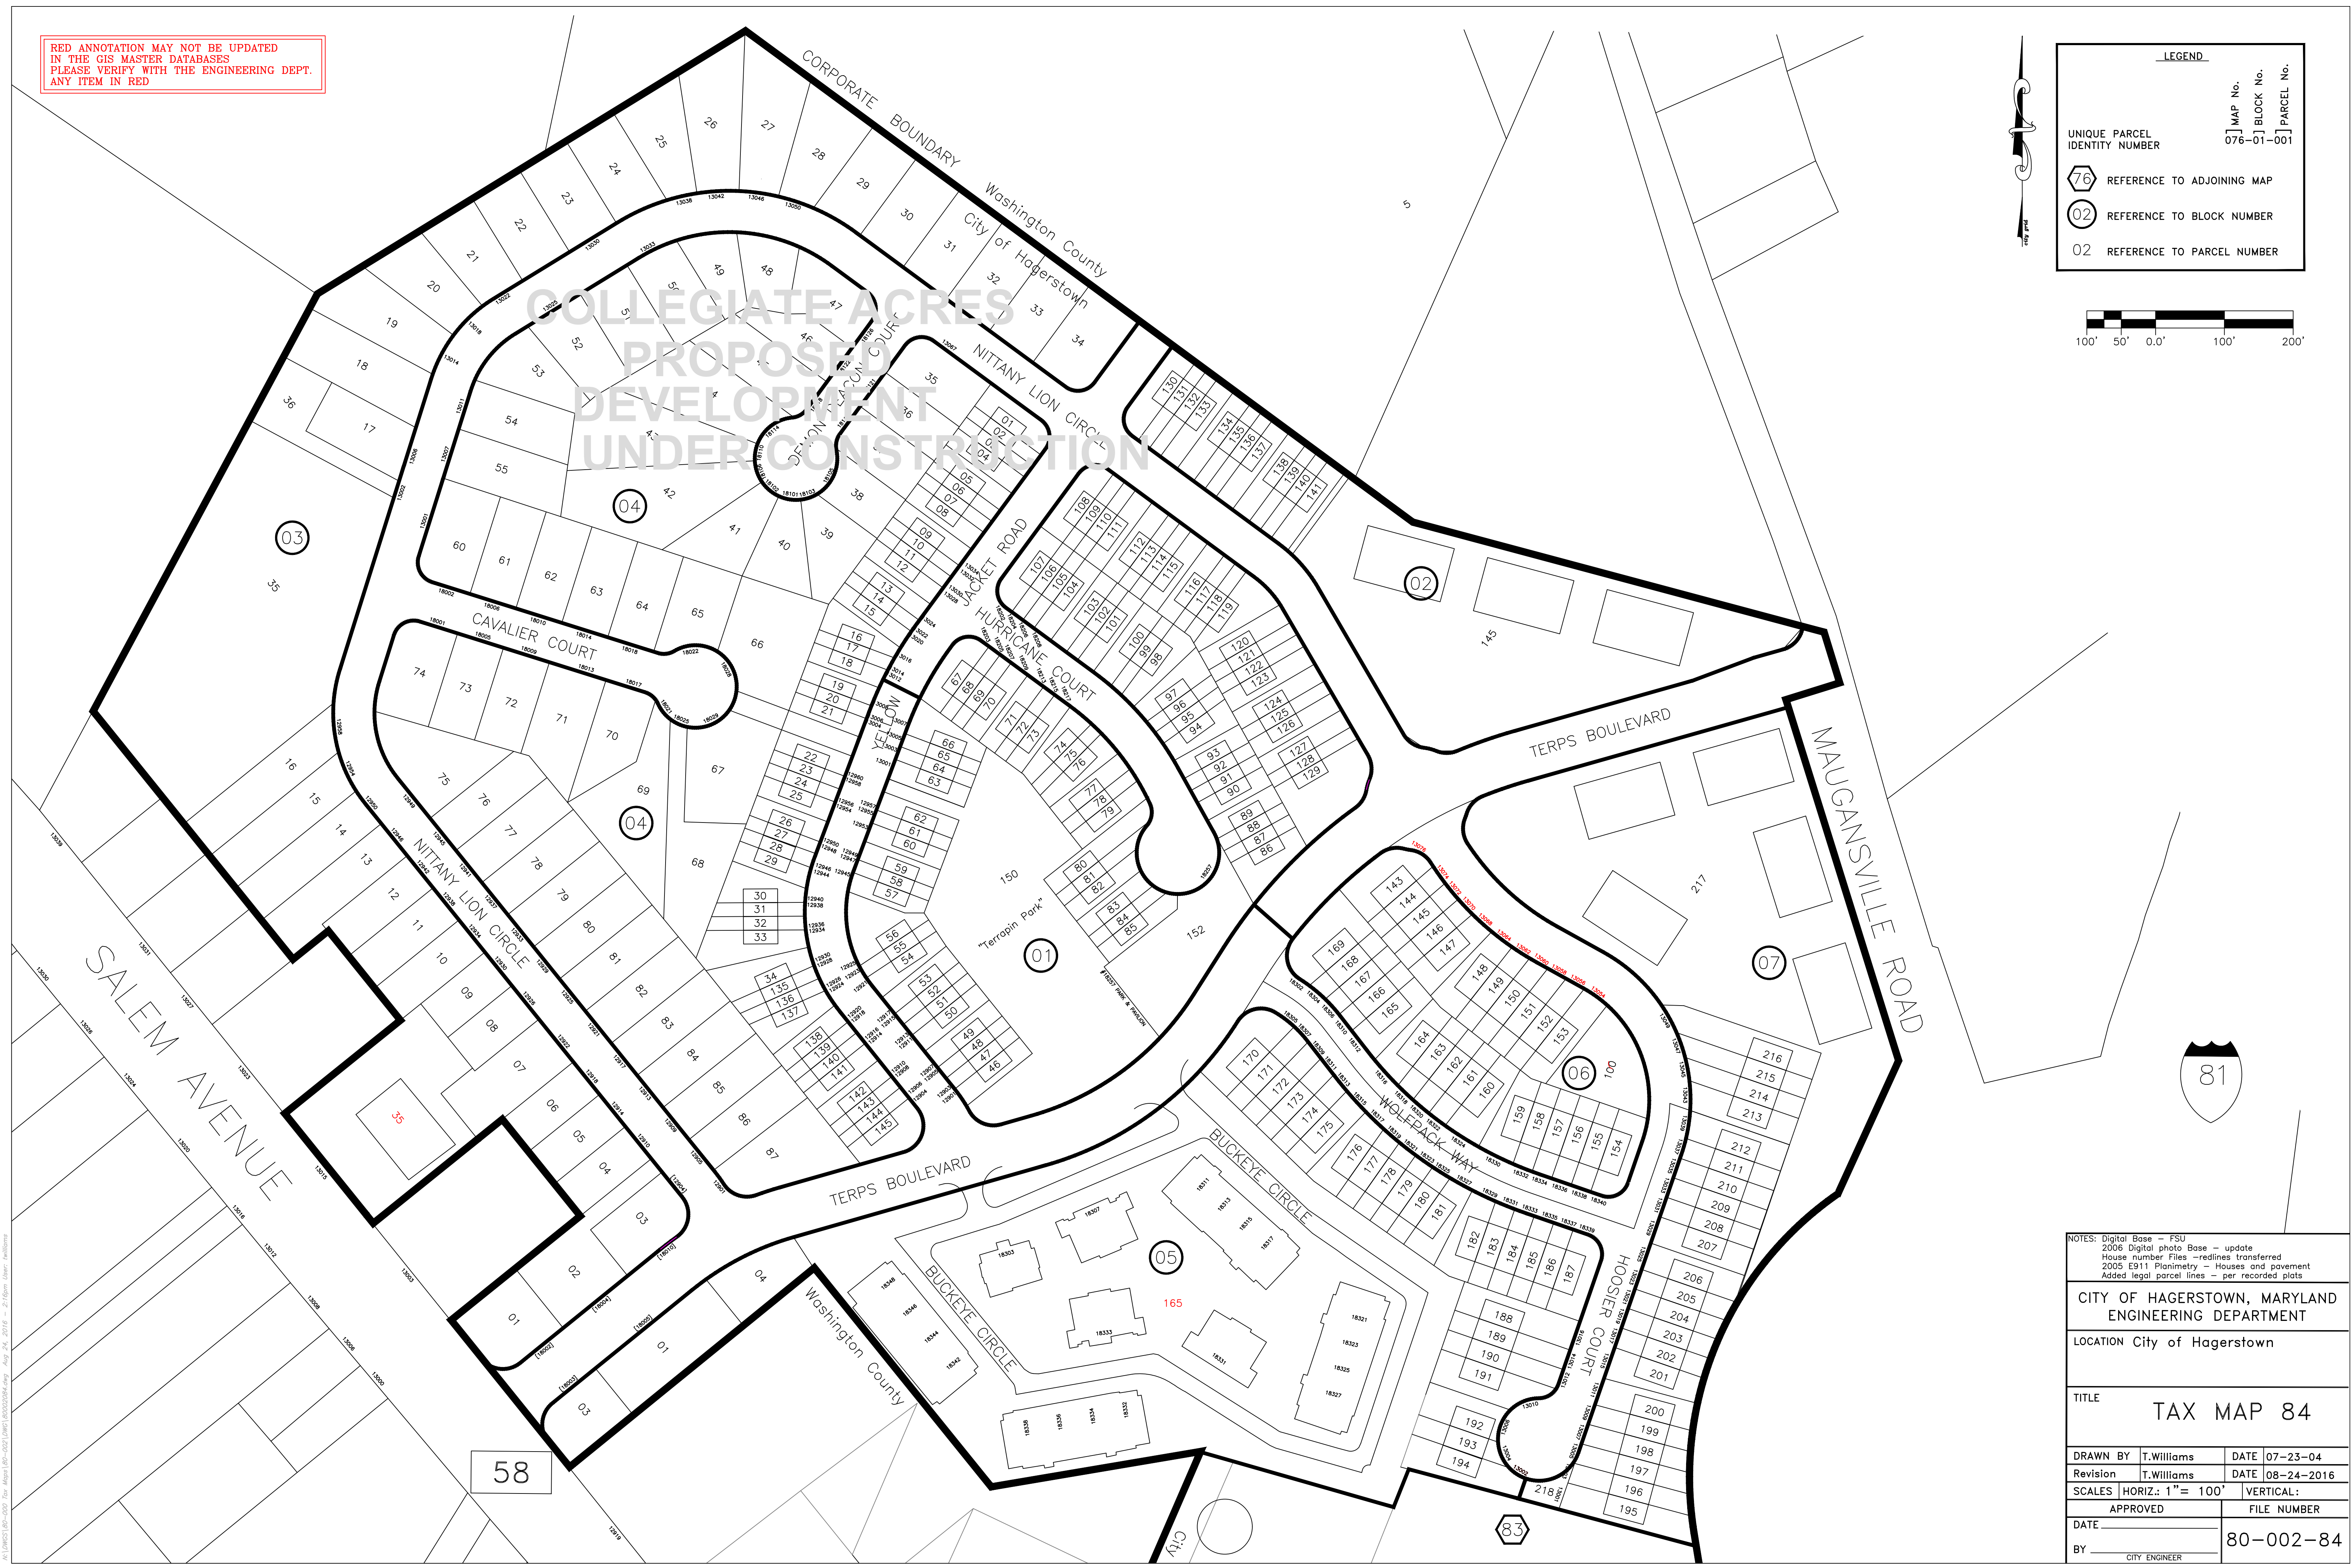

NOTES: Digital Base - FSJ  
 2006 Digital photo Base - update  
 House number Files - redlines transferred  
 2005 E911 Planimetry - Houses and pavement  
 Added legal parcel lines - per recorded plats

CITY OF HAGERSTOWN, MARYLAND ENGINEERING DEPARTMENT	
LOCATION City of Hagerstown	
TITLE <b>TAX MAP 84</b>	
DRAWN BY T.Williams	DATE 07-23-04
Revision T.Williams	DATE 08-24-2016
SCALES HORIZ.: 1"= 100'	VERTICAL:
APPROVED	FILE NUMBER
DATE	80-002-84
BY	CITY ENGINEER

All parcels shown on this map were derived from the following sources:  
 2006 Digital photo Base - update  
 House number Files - redlines transferred  
 2005 E911 Planimetry - Houses and pavement  
 Added legal parcel lines - per recorded plats