



STREET LEVEL FLOOR PLAN  
1,612 SQ. FT.

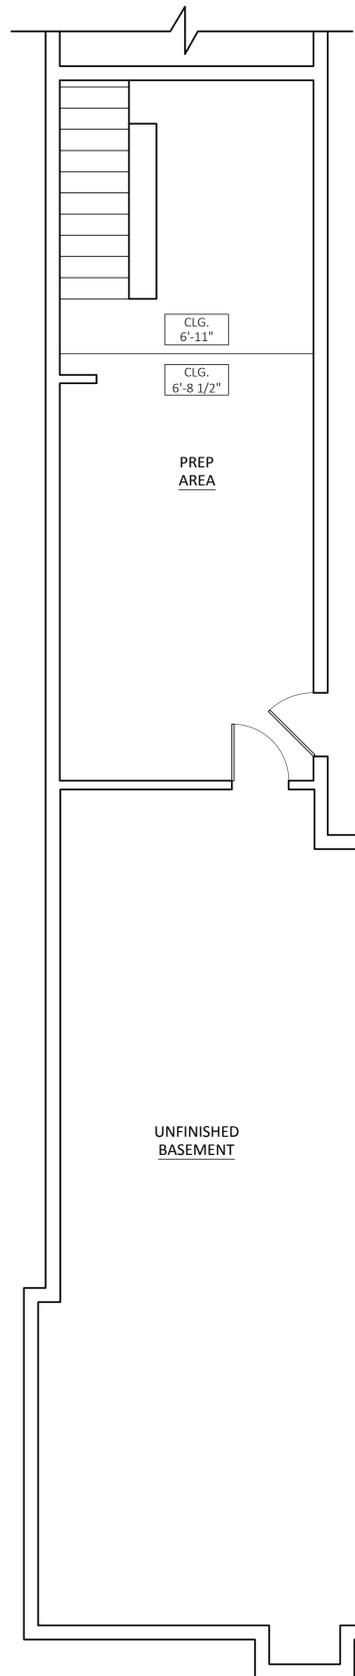


BASEMENT LEVEL FLOOR PLAN  
967 SQ. FT.

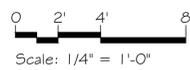


Date Prepared: April 29, 2013

Prepared by: Robert Goldsack Hospitality Architect, LLC. 145 West Washington Street Hagerstown, Maryland Telephone: 240-625-9057


As-Built Floor Plan  
40 North Potomac Street Hagerstown, MD 21740

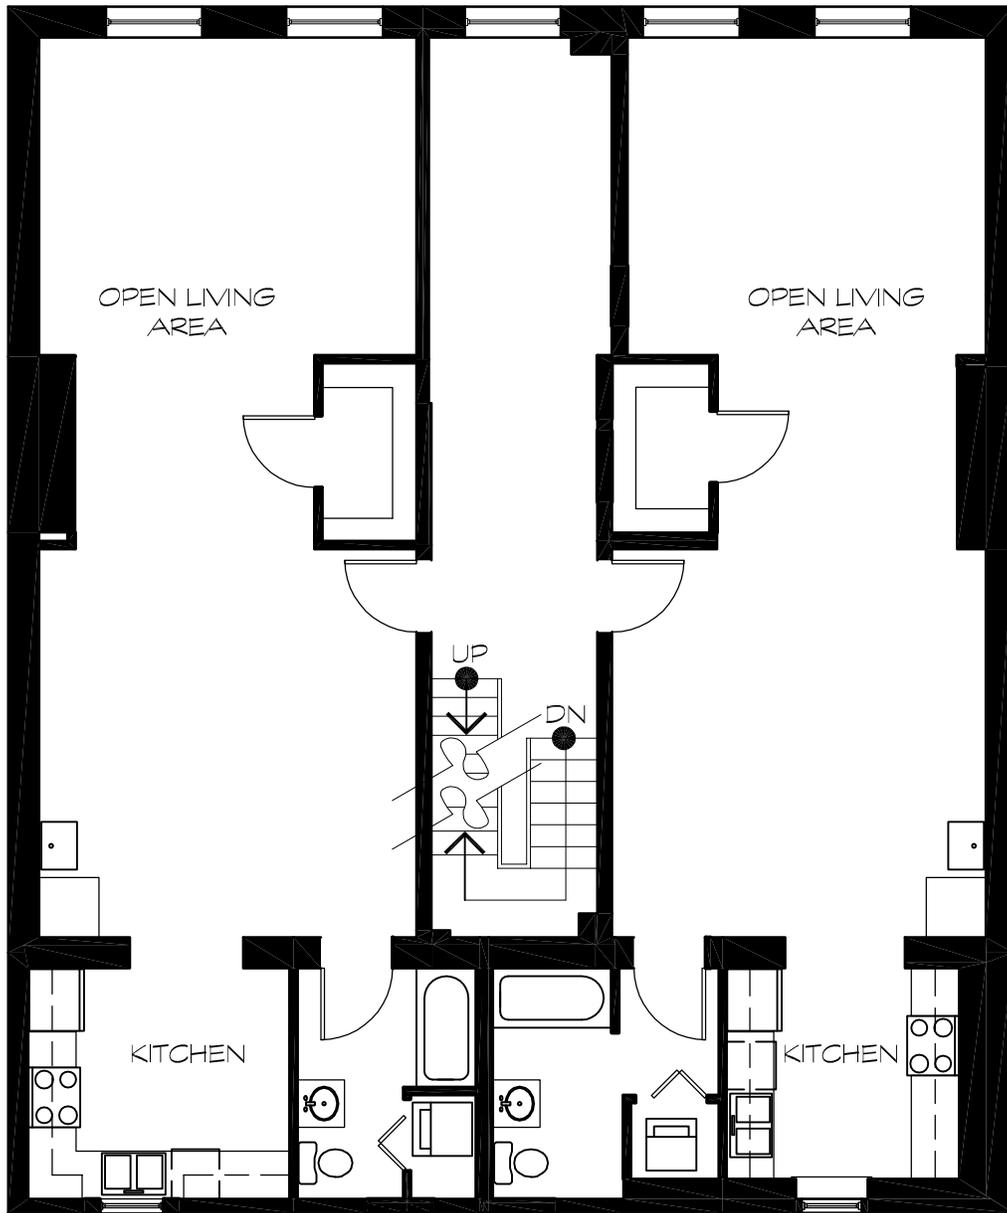


SECOND FLOOR PLAN  
 CITY OF HAGERSTOWN  
 THE STUDIOS ON NOPO

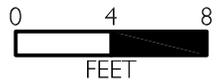

November 1, 2013

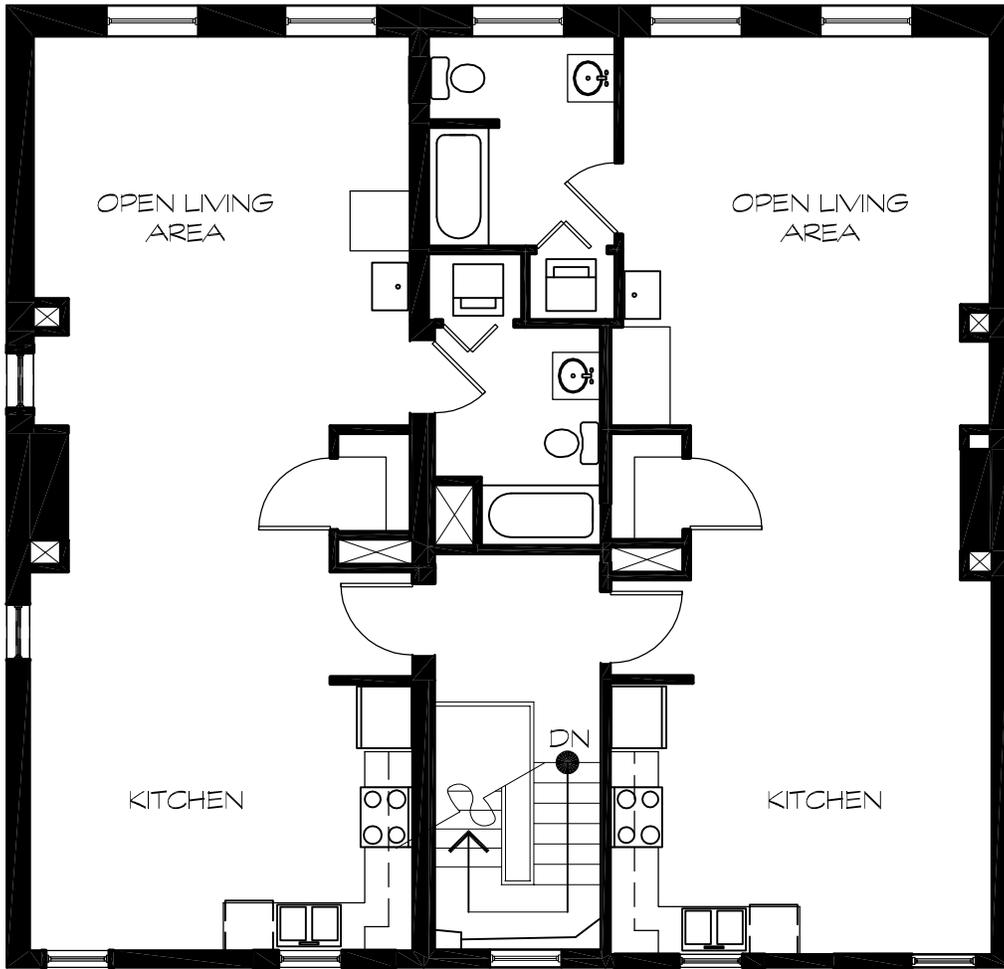

THIRD FLOOR PLAN  
 CITY OF HAGERSTOWN  
 THE STUDIOS ON NOPO

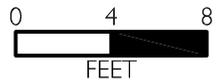

November 1, 2013