

E-911 LEGEND


- BUILDING FOOTPRINTS 4-2005
- ROAD CARTWAY 4-2005
- PARKING AREA 4-2005

Provided by: E911 Numbers Board,
Spring 2005 Flight.


LEGEND

UNIQUE PARCEL IDENTITY NUMBER	MAP No.	BLOCK No.	PARCEL No.
	076-01-001		

- REFERENCE TO ADJOINING MAP
- REFERENCE TO BLOCK NUMBER
- REFERENCE TO PARCEL NUMBER

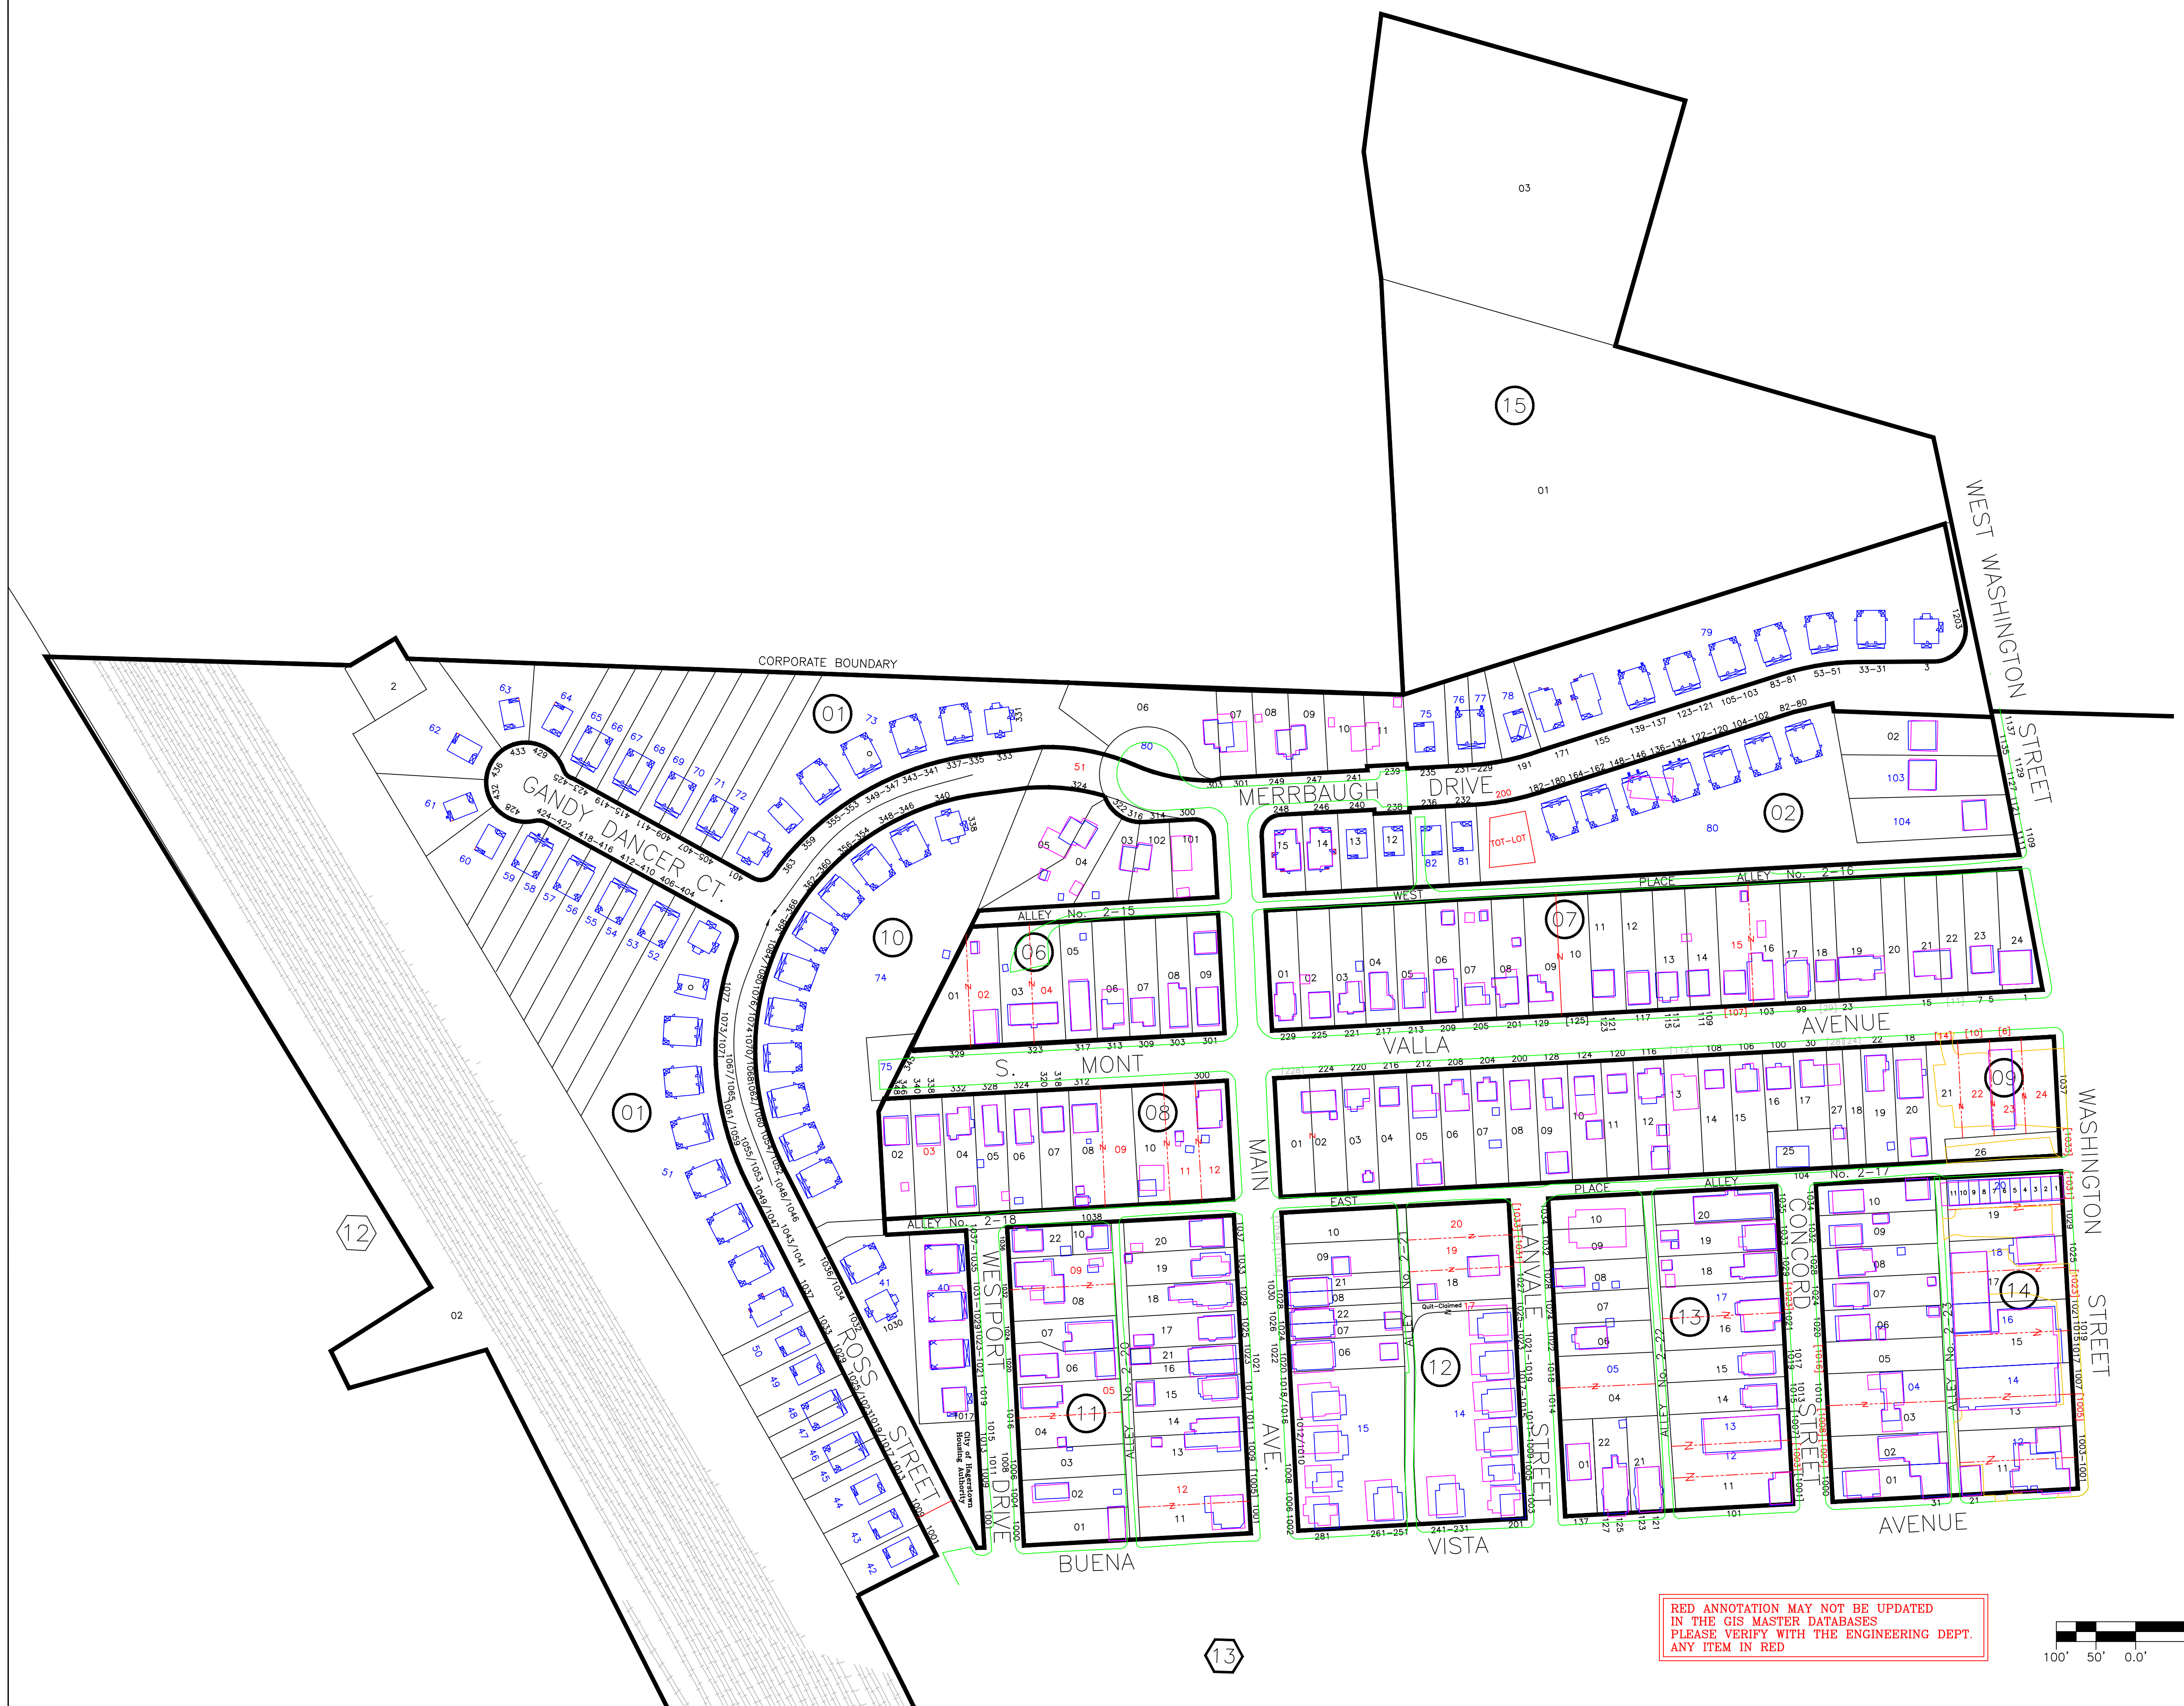

RED ANNOTATION MAY NOT BE UPDATED
IN THE GIS MASTER DATABASES
PLEASE VERIFY WITH THE ENGINEERING DEPT.
ANY ITEM IN RED

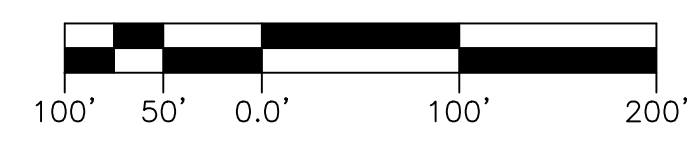

NOTES: Digital Base - FSU
2006 Digital photo Base - update
House number Files - redlines transferred
2005 E911 Planimetry - Houses and pavement
Added legal parcel lines - per recorded plats

CITY OF HAGERSTOWN, MARYLAND ENGINEERING DEPARTMENT			
LOCATION City of Hagerstown			
TITLE TAX MAP 4			
DRAWN BY	T.Williams	DATE	12-20-01
Revision	T.Williams	DATE	08-16-11
SCALES	HORIZ.: 1" = 100'	VERTICAL:	
APPROVED		FILE NUMBER	
DATE		80-002-04	
BY	CITY ENGINEER		

K:\DWG\100-001-001-002\Draw\10002004.dwg Aug 16, 2011 4:07pm User: twilliams