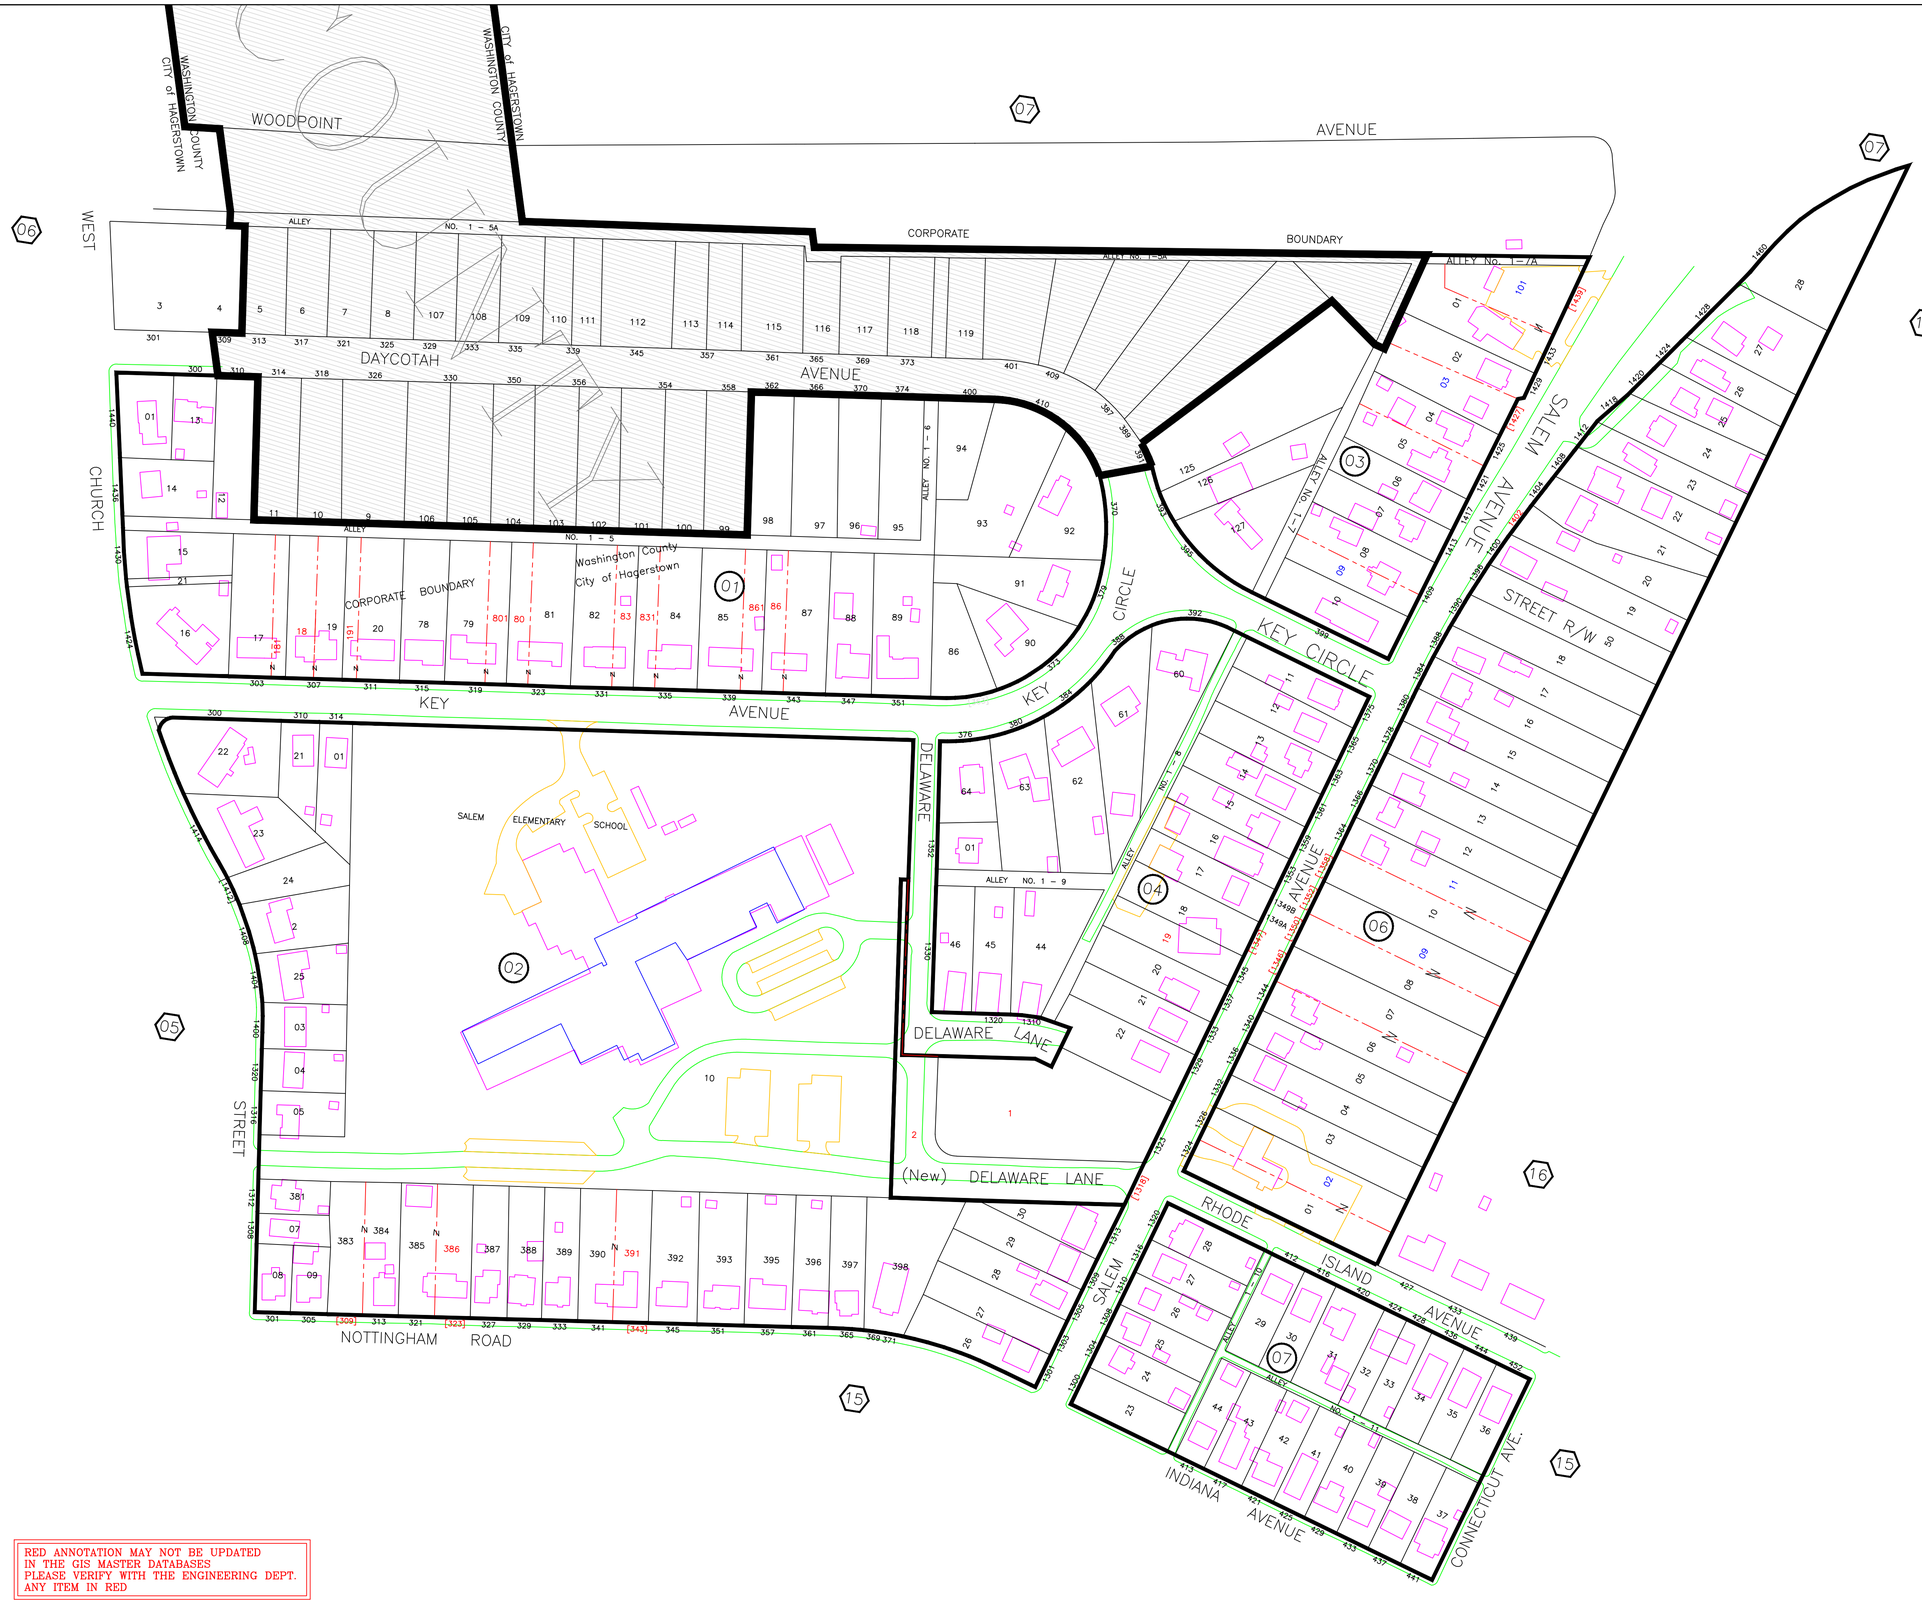

E-911 LEGEND

- BUILDING FOOTPRINTS 4-2005
- ROAD CARTWAY 4-2005
- PARKING AREA 4-2005

Provided by: E911 Numbers Board, Spring 2005 Flight.

LEGEND

UNIQUE PARCEL IDENTITY NUMBER — MAP No. / BLOCK No. / PARCEL No. — 076-01-001

76 REFERENCE TO ADJOINING MAP

02 REFERENCE TO BLOCK NUMBER

02 REFERENCE TO PARCEL NUMBER

[1520] UN-RELEASED ADDRESS

100' 50' 0.0' 100' 200'

RED ANNOTATION MAY NOT BE UPDATED
IN THE GIS MASTER DATABASES
PLEASE VERIFY WITH THE ENGINEERING DEPT.
ANY ITEM IN RED

NOTES: Digital Base – FSU
2006 Digital photo Base – update
House number Files –redlines transferred
2005 E911 Planimetry – Houses and pavement
Added legal parcel lines – per recorded plats

CITY OF HAGERSTOWN, MARYLAND
ENGINEERING DEPARTMENT

LOCATION City of Hagerstown

TITLE TAX MAP 8

DRAWN BY	T.Williams	DATE	01-28-02
Revision	T.Williams	DATE	08-18-11
SCALES	HORIZ.: 1"= 100'	VERTICAL:	

APPROVED	FILE NUMBER
DATE _____ BY _____ CITY ENGINEER	80-002-08