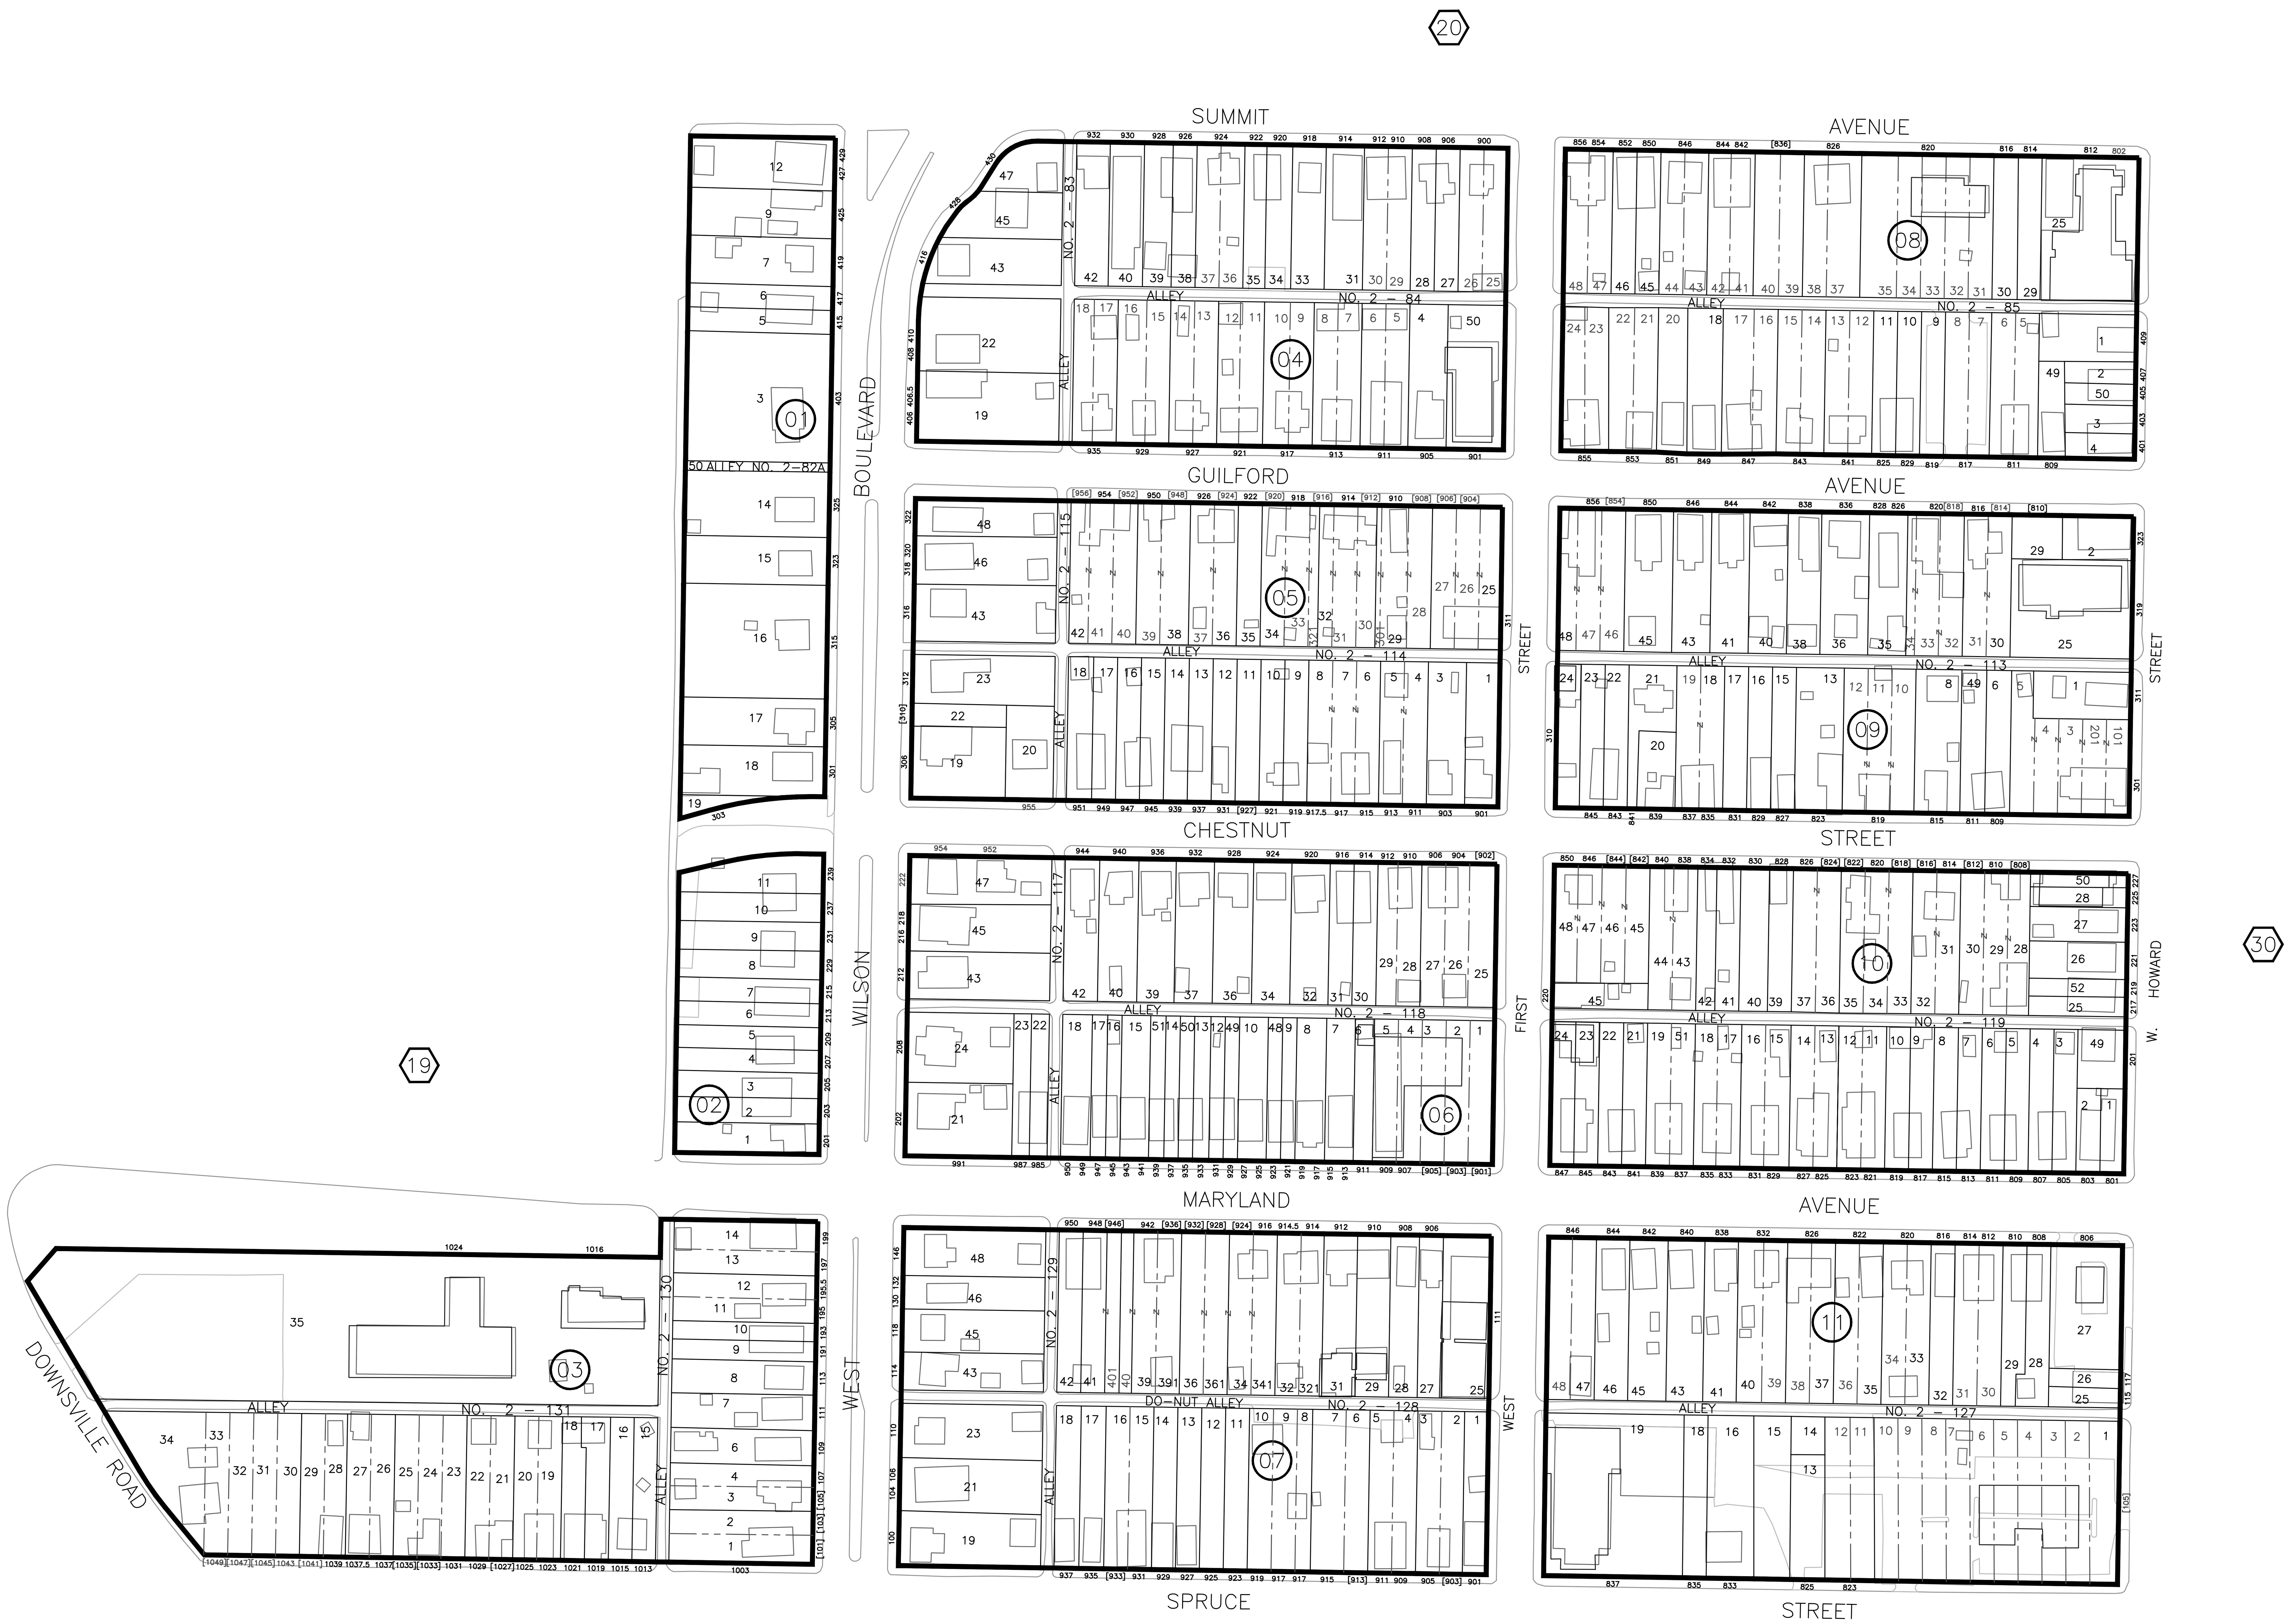

E-911 LEGEND
BUILDING FOOTPRINTS 4–2005
ROAD CARTWAY 4–2005
PARKING AREA 4–2005
Provided by: E911 Numbers Board, Spring 2005 Flight.

LEGEND

UNIQUE PARCEL IDENTITY NUMBER 076–01–001 (MAP No. – BLOCK No. – PARCEL No.)

- 76 REFERENCE TO ADJOINING MAP
- 02 REFERENCE TO BLOCK NUMBER
- 02 REFERENCE TO PARCEL NUMBER

100' 50' 0.0' 100' 200'

NOTES: Digital Base – FSU
2006 Digital photo Base – update
House number Files –redlines transferred
2005 E911 Planimetry – Houses and pavement
Added legal parcel lines – per recorded plats

RED ANNOTATION MAY NOT BE UPDATED
IN THE GIS MASTER DATABASES
PLEASE VERIFY WITH THE ENGINEERING DEPT.
ANY ITEM IN RED

CITY OF HAGERSTOWN, MARYLAND
ENGINEERING DEPARTMENT

LOCATION City of Hagerstown

TITLE

TAX MAP 29

DRAWN BY	T.Williams	DATE	10–07–02
Revision	T.Williams	DATE	05–27–10
SCALES	HORIZ.: 1"= 100'	VERTICAL:	

APPROVED	FILE NUMBER
DATE ______ BY ______ CITY ENGINEER	80–002–29