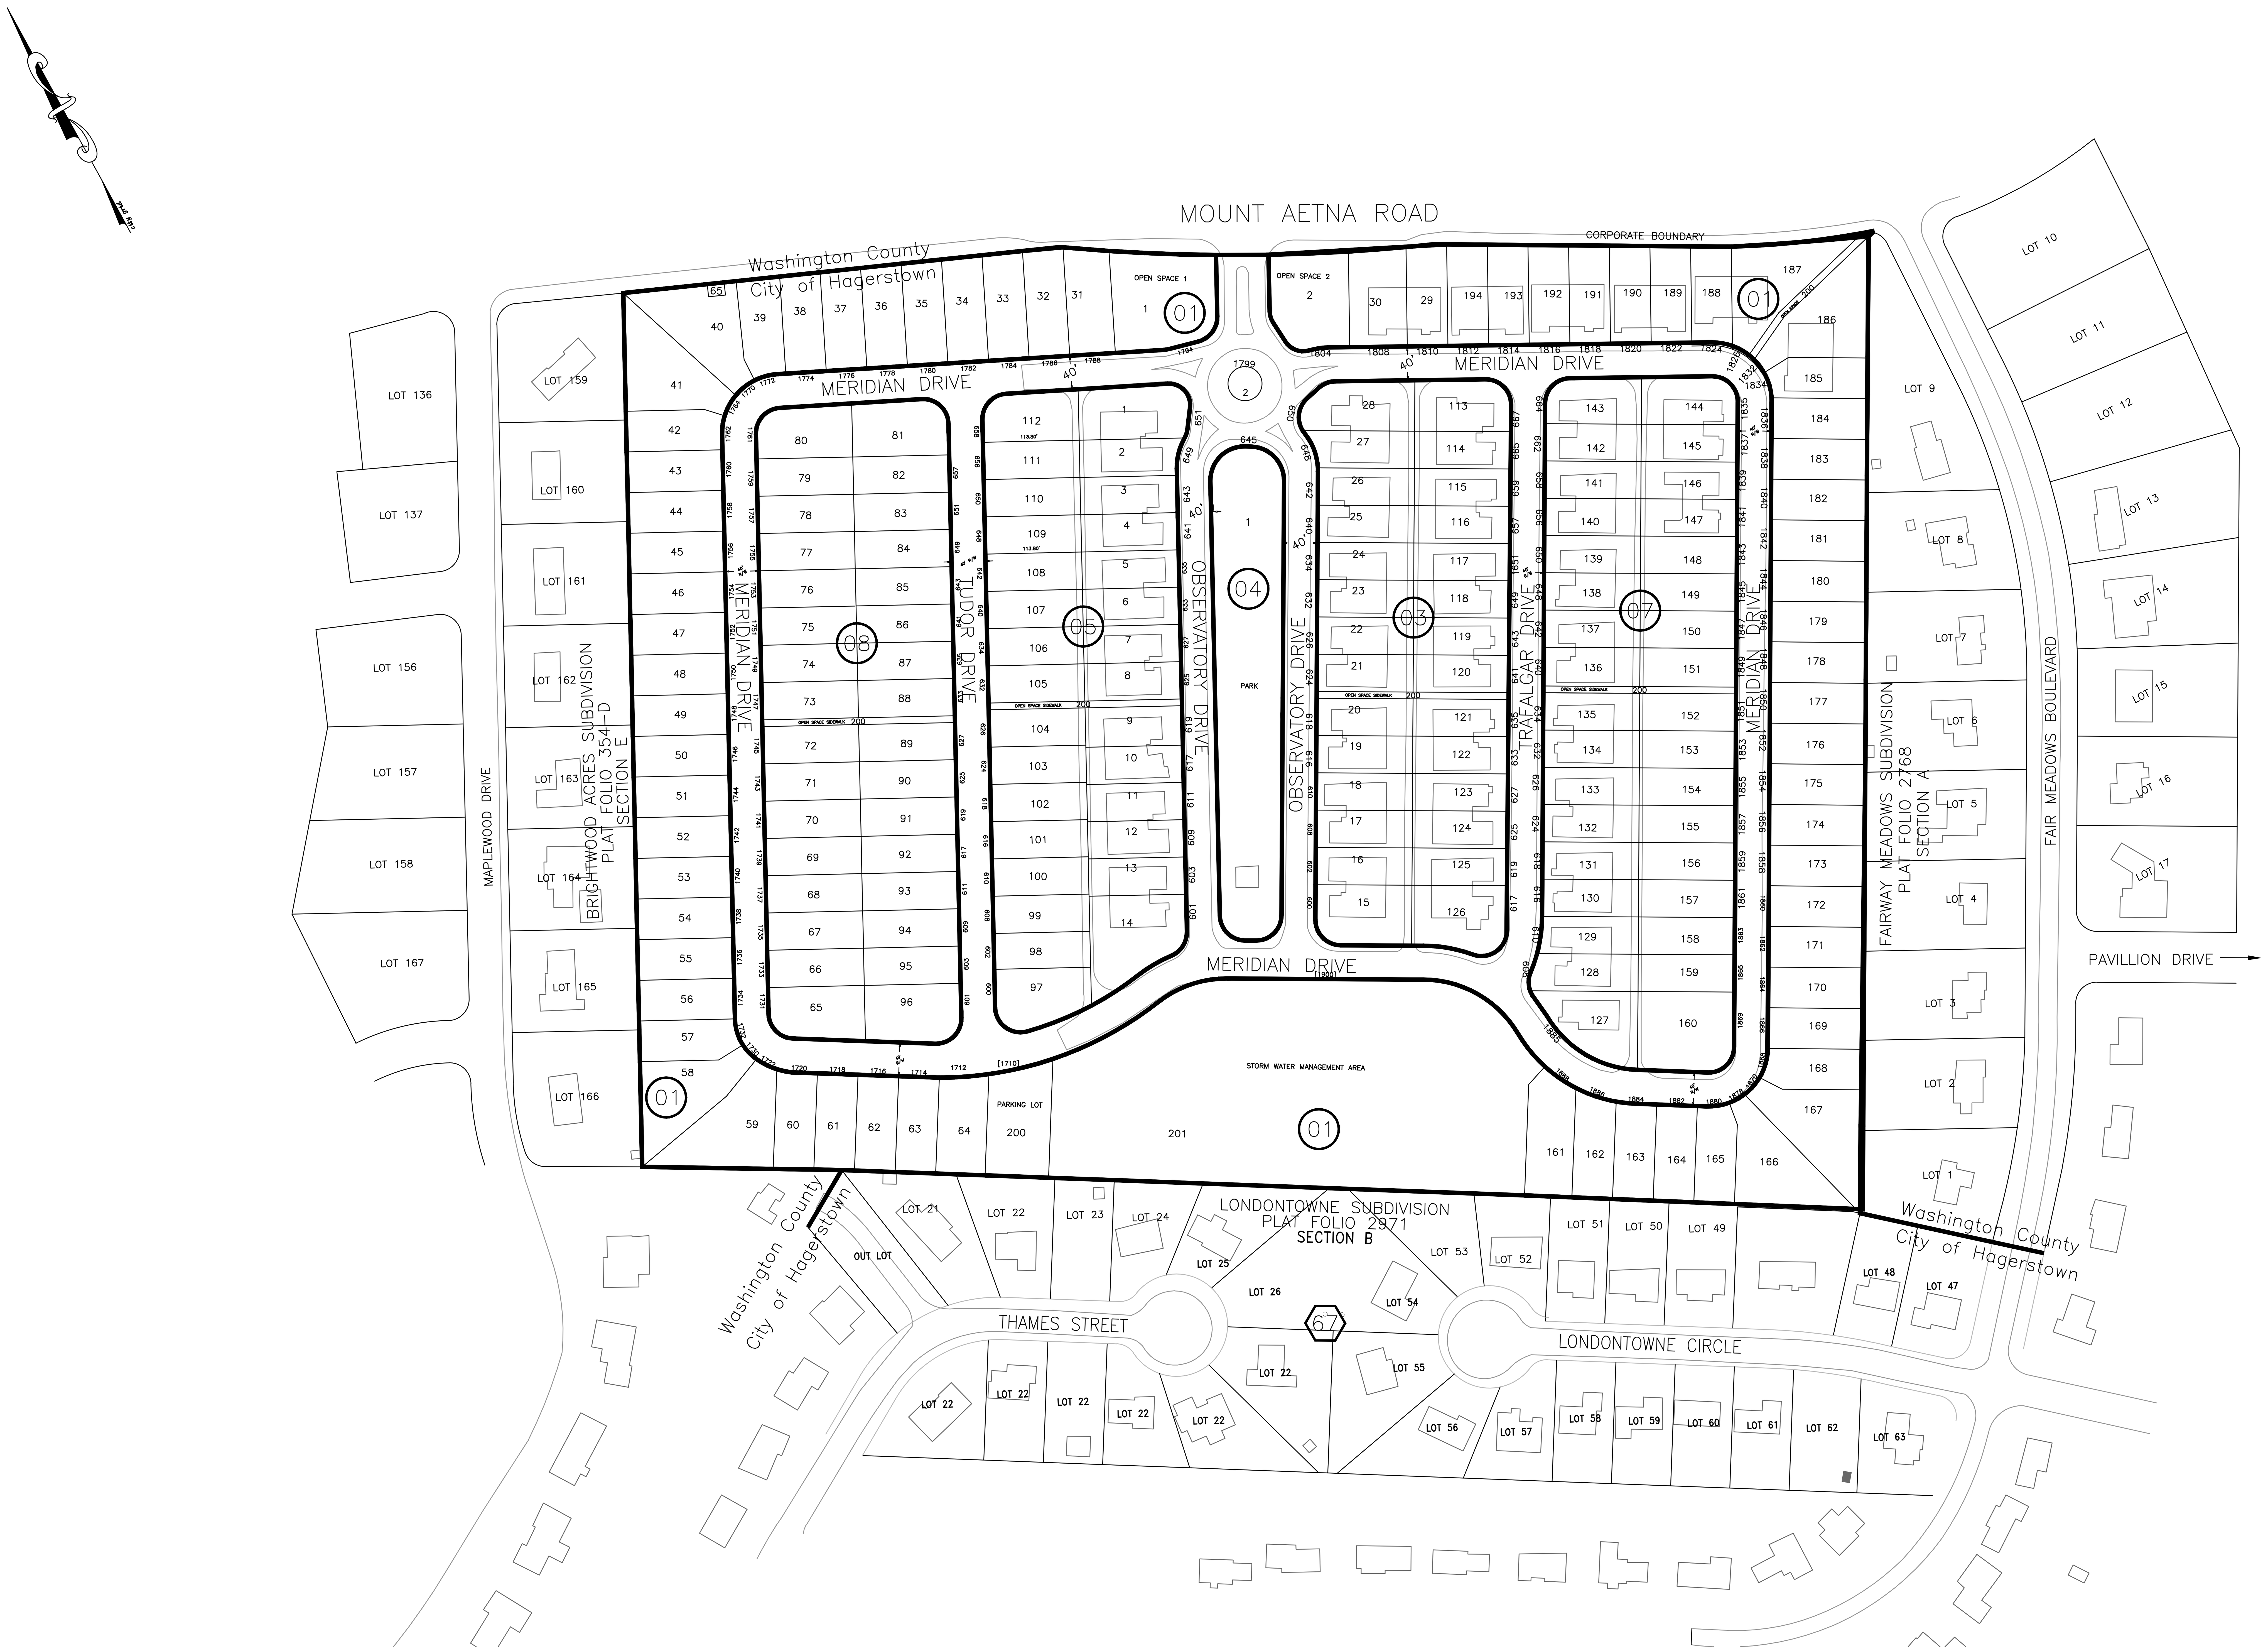

LEGEND

UNIQUE PARCEL IDENTITY NUMBER — MAP No. / BLOCK No. / PARCEL No. — 076-01-001

(76) REFERENCE TO ADJOINING MAP

(02) REFERENCE TO BLOCK NUMBER

02 REFERENCE TO PARCEL NUMBER

E-911 LEGEND

BUILDING FOOTPRINTS 4-2005

ROAD CARTWAY 4-2005

PARKING AREA 4-2005

Provided by: E911 Numbers Board, Spring 2005 Flight.

RED ANNOTATION MAY NOT BE UPDATED
IN THE GIS MASTER DATABASES
PLEASE VERIFY WITH THE ENGINEERING DEPT.
ANY ITEM IN RED

NOTES: Digital Base – FSU
2006 Digital photo Base – update
House number Files –redlines transferred
2005 E911 Planimetry – Houses and pavement
Added legal parcel lines – per recorded plats

CITY OF HAGERSTOWN, MARYLAND
ENGINEERING DEPARTMENT

LOCATION City of Hagerstown

TITLE

TAX MAP 76

DRAWN BY	T.Williams	DATE	03-02-01
Revision	T.Williams	DATE	08-31-09
SCALES	HORIZ.: 1"= 100'	VERTICAL:	
APPROVED		FILE NUMBER	
DATE		80-002-76	
BY	CITY ENGINEER		