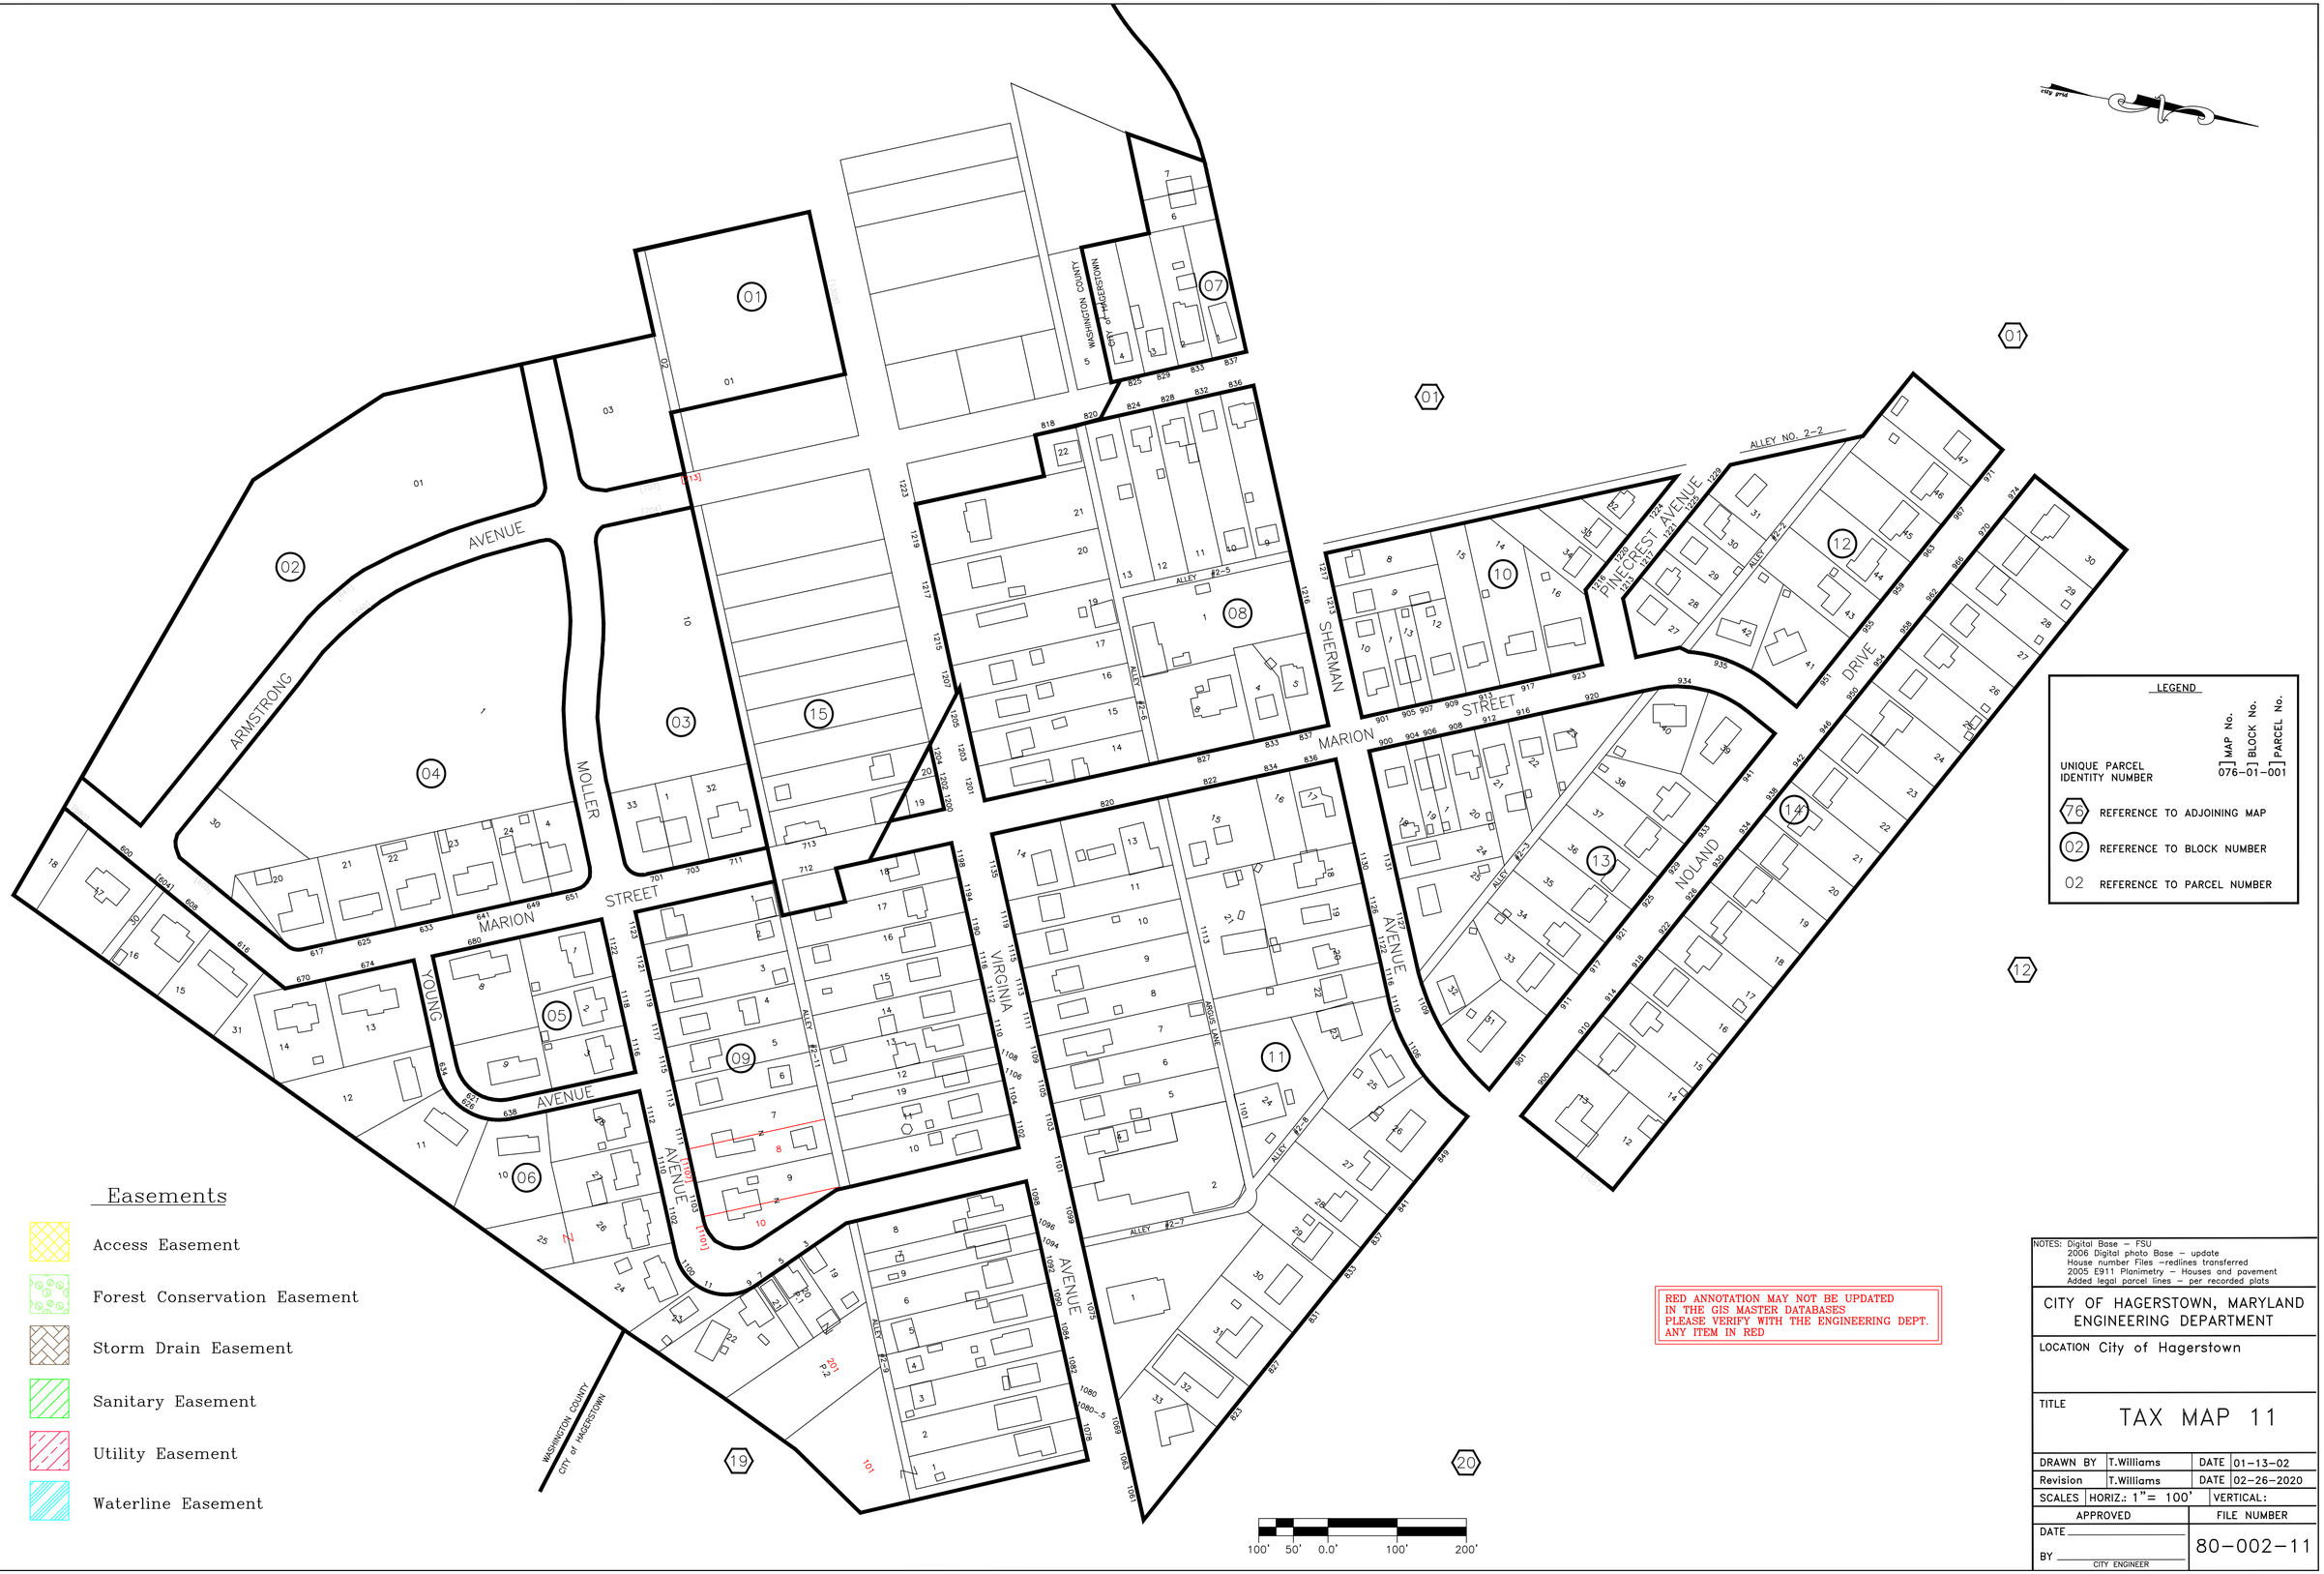

RED ANNOTATION MAY NOT BE UPDATED IN THE GIS MASTER DATABASES PLEASE VERIFY WITH THE ENGINEERING DEPT. ANY ITEM IN RED

NOTES: Digital Base – FSU
2006 Digital photo Base – update
House number Files –redlines transferred
2005 E911 Planimetry – Houses and pavement
Added legal parcel lines – per recorded plats

CITY OF HAGERSTOWN, MARYLAND
ENGINEERING DEPARTMENT

LOCATION City of Hagerstown

TITLE TAX MAP 11

DRAWN BY	T.Williams	DATE	01-13-02
Revision	T.Williams	DATE	02-26-2020
SCALES	HORIZ.: 1"= 100'	VERTICAL:	
APPROVED		FILE NUMBER	
DATE		80-002-11	
BY	CITY ENGINEER		