

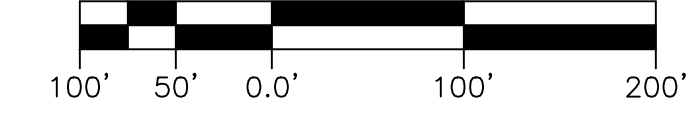


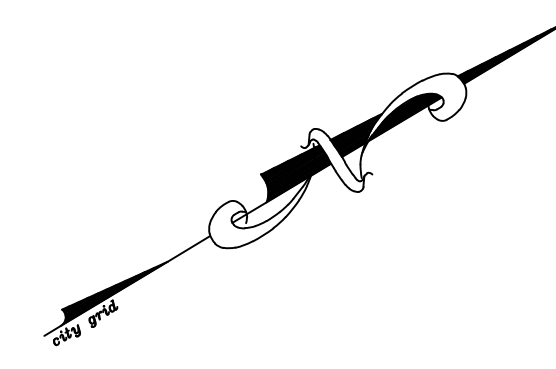

Easements

-  Access Easement
-  Forest Conservation Easement
-  Storm Drain Easement
-  Sanitary Easement
-  Utility Easement
-  Waterline Easement

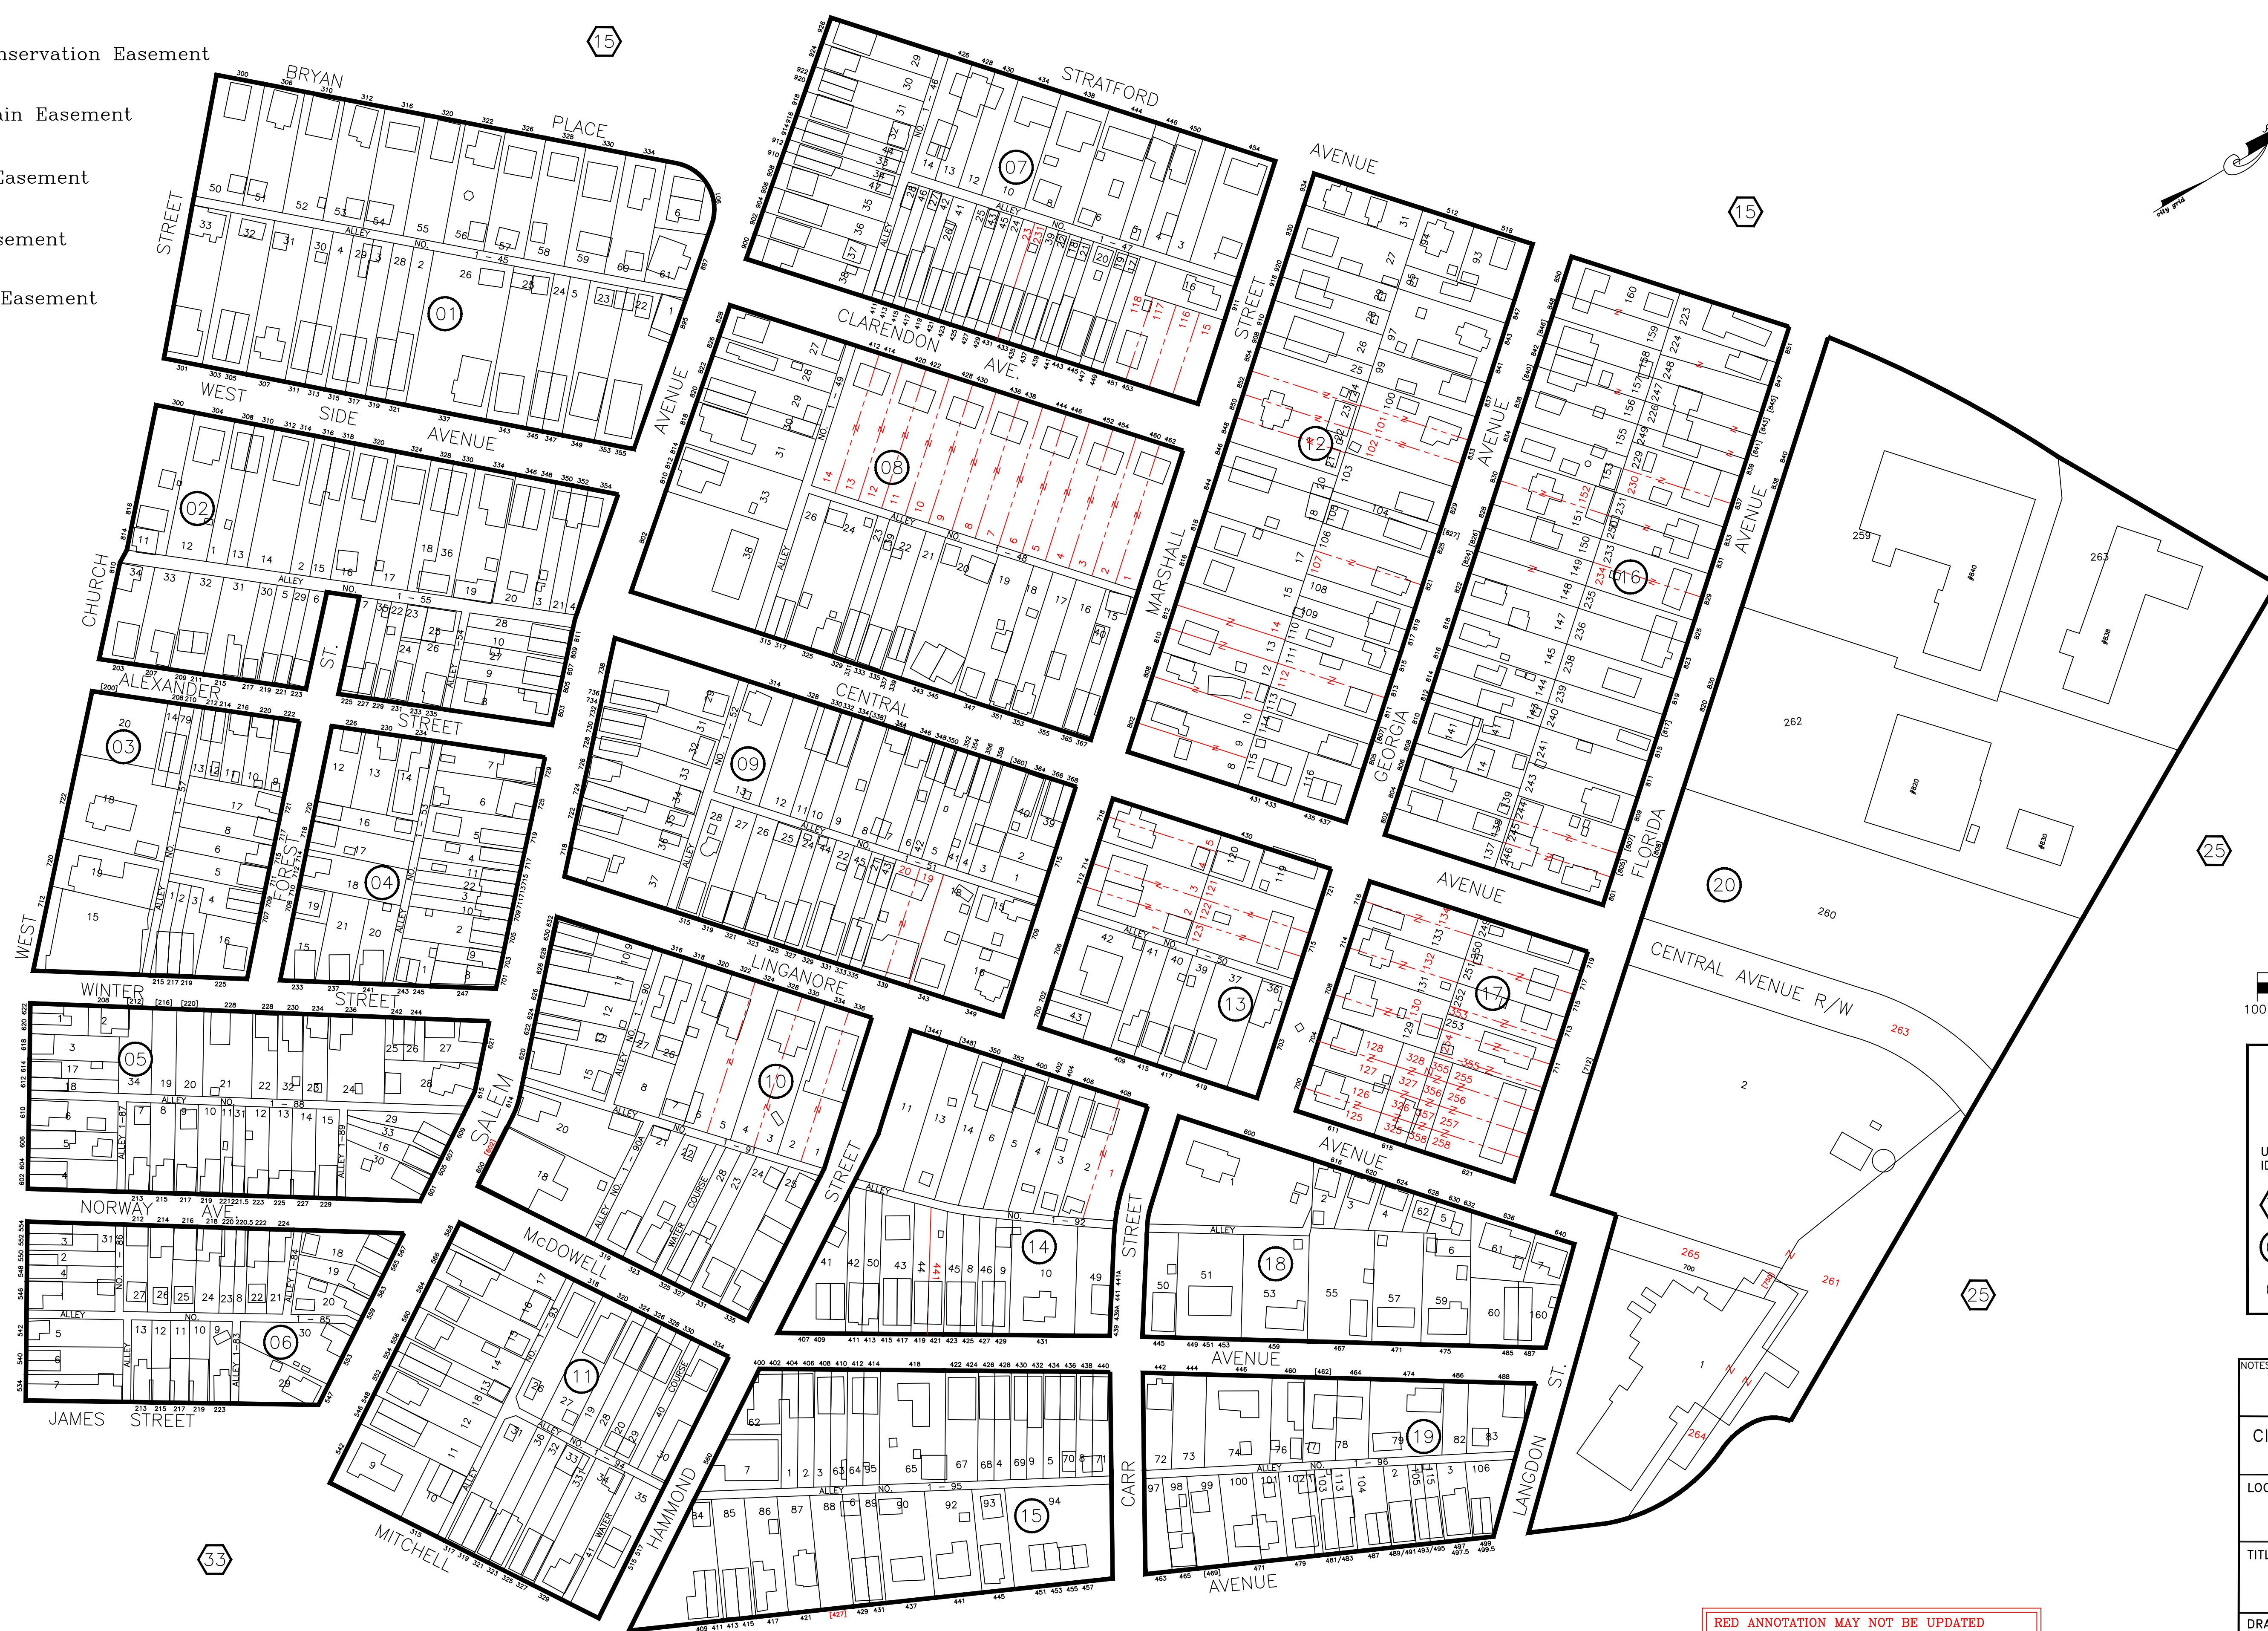

LEGEND		
UNIQUE PARCEL IDENTITY NUMBER	MAP No.	BLOCK No.
		PARCEL No.
	076-01-001	
	REFERENCE TO ADJOINING MAP	
	REFERENCE TO BLOCK NUMBER	
02	REFERENCE TO PARCEL NUMBER	

NOTES: Digital Base – FSU 2006 Digital photo Base – update House number Files –redlines transferred 2005 E911 Planimetry – Houses and pavement Added legal parcel lines – per recorded plats	
CITY OF HAGERSTOWN, MARYLAND ENGINEERING DEPARTMENT	
LOCATION City of Hagerstown	
TITLE TAX MAP 24	
DRAWN BY T.Williams	DATE 08-23-02
Revision T.Williams	DATE 12-30-2019
SCALES HORIZ.: 1"= 100'	VERTICAL:
APPROVED	FILE NUMBER
DATE	80-002-24
BY CITY ENGINEER	

RED ANNOTATION MAY NOT BE UPDATED
IN THE GIS MASTER DATABASES
PLEASE VERIFY WITH THE ENGINEERING DEPT.
ANY ITEM IN RED

\\hgs01\GIS\2019\Tax Map\24\20190823\24_Tax_Map_08-23-2019.mxd