
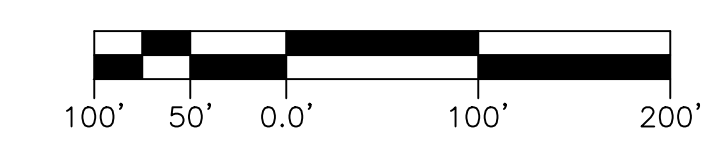
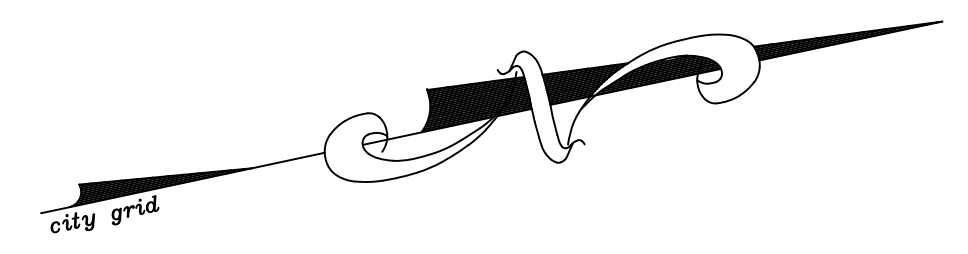


- South Prospect Historic District
- Downtown Historic District
- Potomac/Broadway Historic District

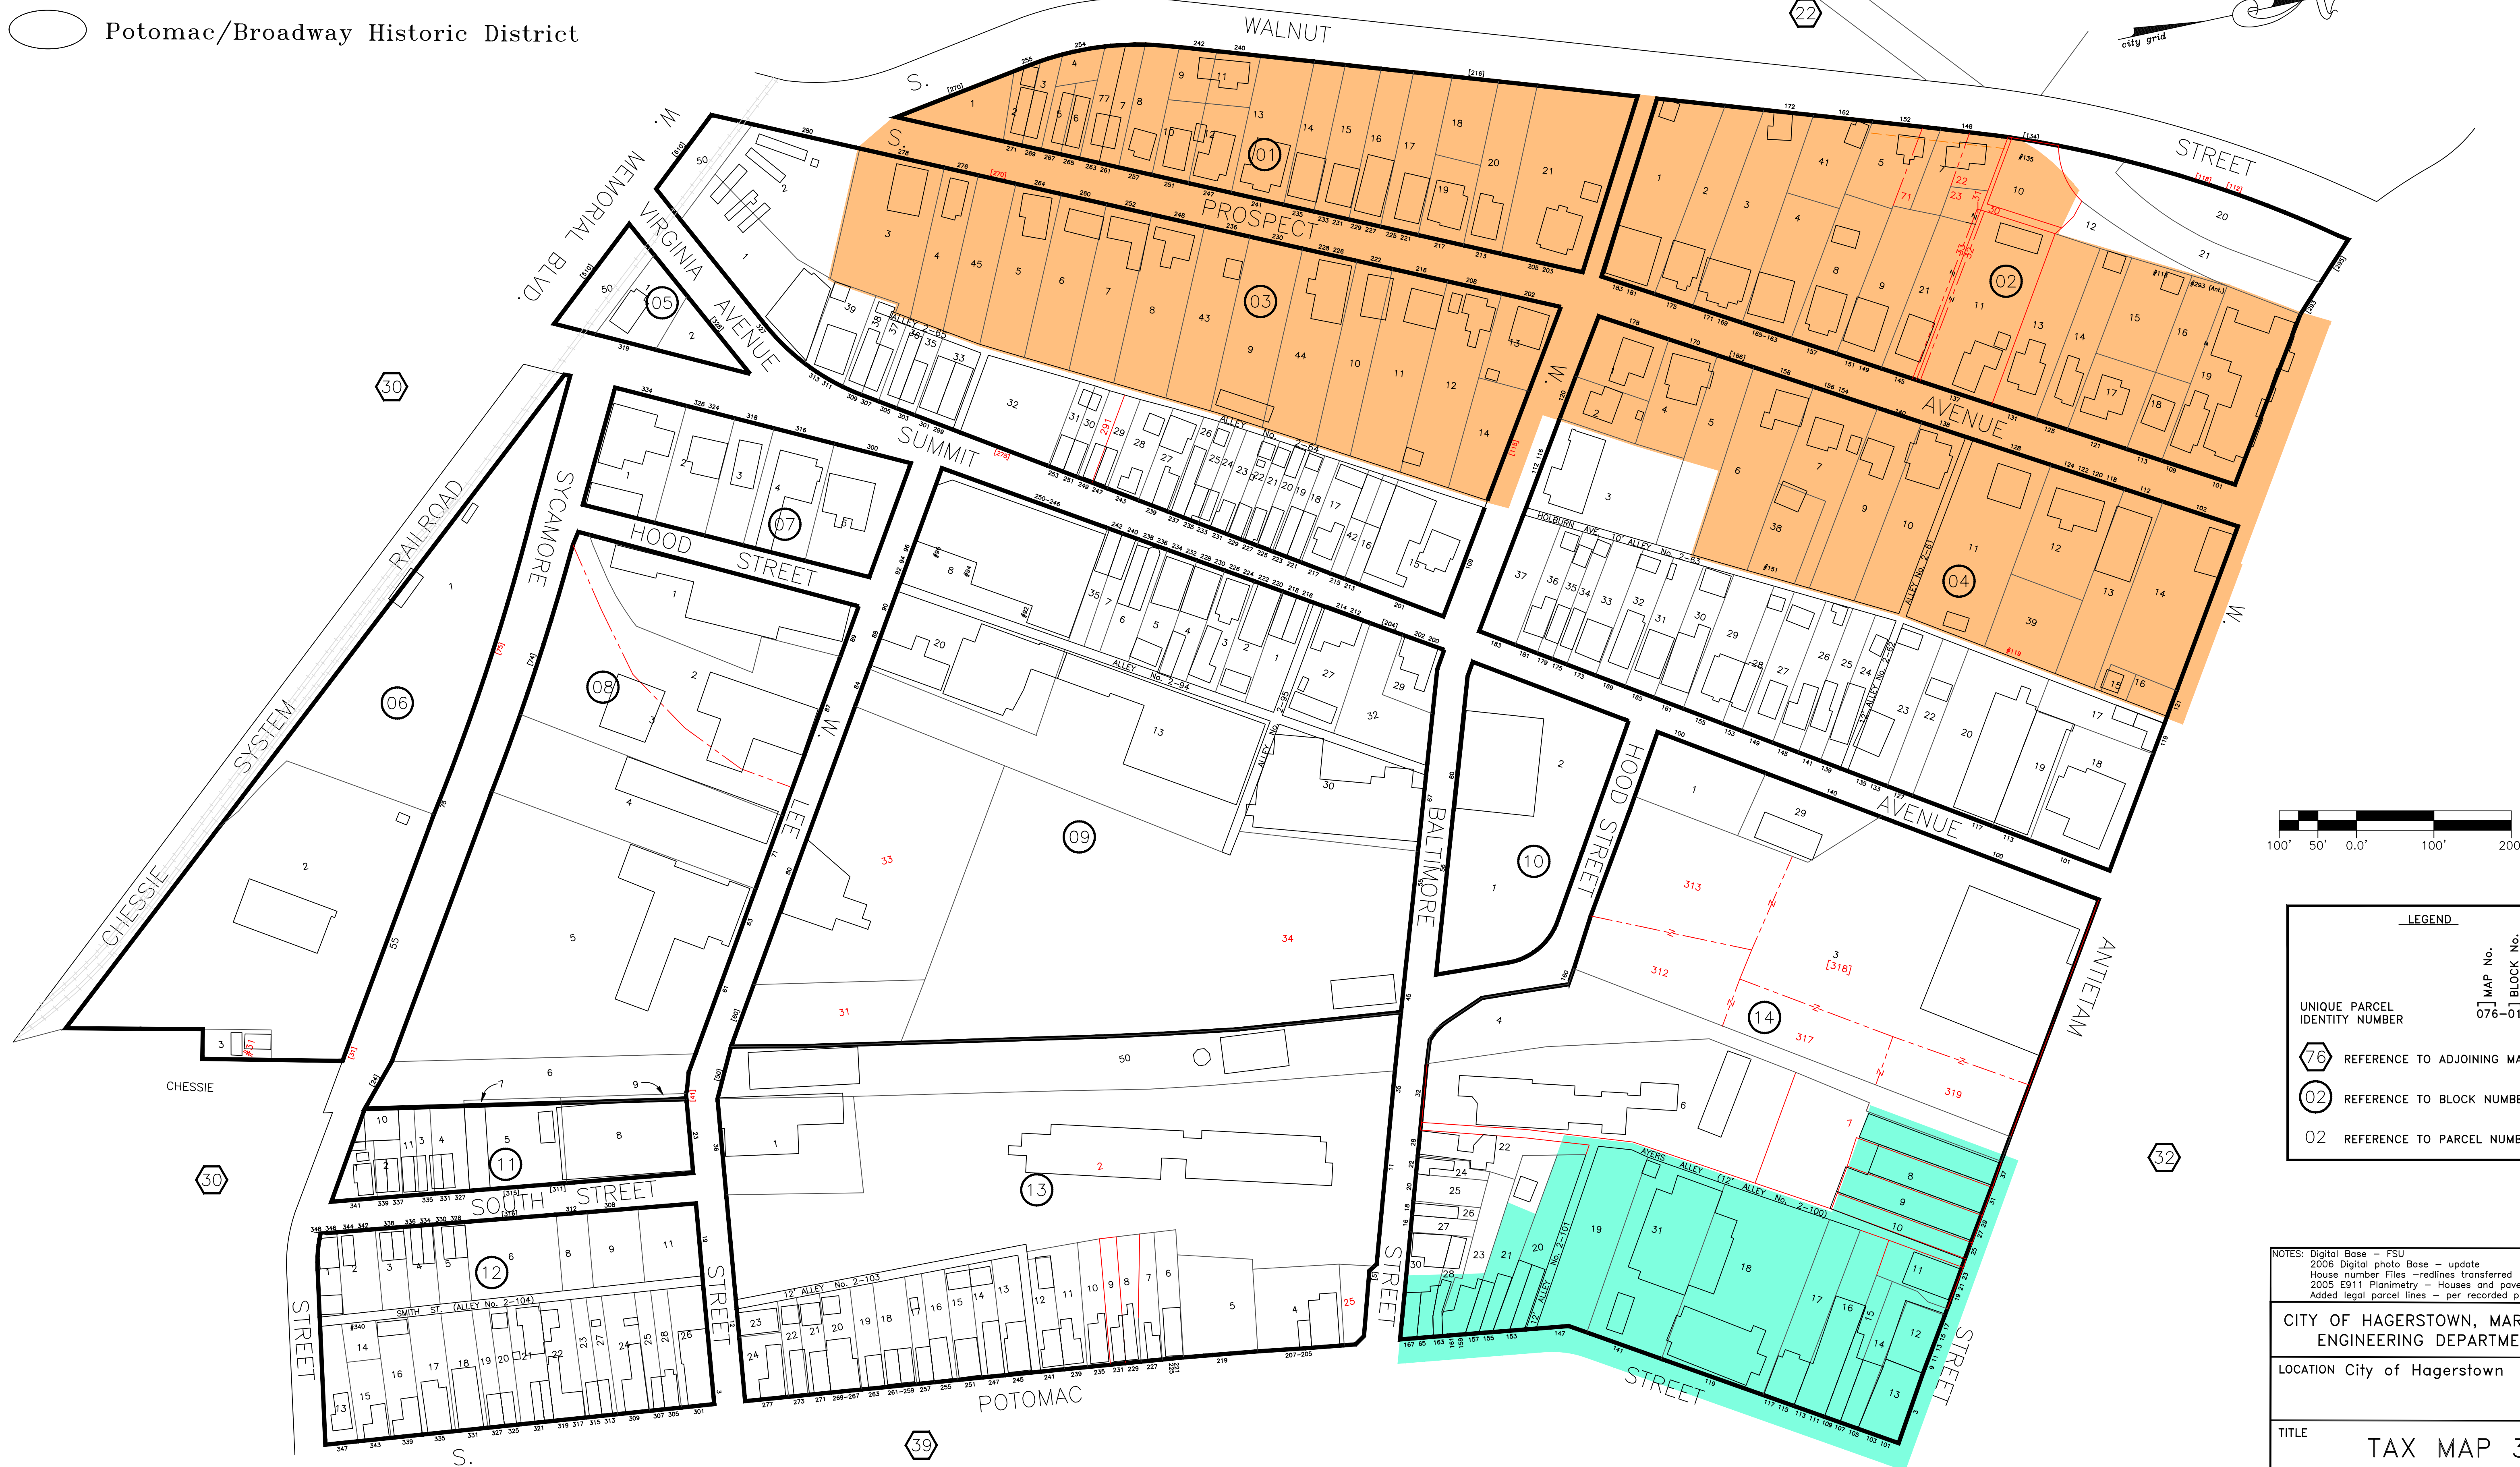

LEGEND	
UNIQUE PARCEL IDENTITY NUMBER	MAP No. BLOCK No. PARCEL No. 076-01-001
76	REFERENCE TO ADJOINING MAP
02	REFERENCE TO BLOCK NUMBER
02	REFERENCE TO PARCEL NUMBER

NOTES: Digital Base - FSU
 2006 Digital photo Base - update
 House number Files - redlines transferred
 2005 E911 Planimetry - Houses and pavement
 Added legal parcel lines - per recorded plats

CITY OF HAGERSTOWN, MARYLAND
 ENGINEERING DEPARTMENT

LOCATION City of Hagerstown

TITLE
TAX MAP 31

DRAWN BY T.Williams	DATE 03-02-01
Revision T.Williams	DATE 03-29-18
SCALES HORIZ.: 1" = 100'	VERTICAL:
APPROVED	FILE NUMBER
DATE	80-002-31
BY CITY ENGINEER	

RED ANNOTATION MAY NOT BE UPDATED
 IN THE GIS MASTER DATABASES.
 PLEASE VERIFY WITH THE ENGINEERING DEPT.
 ANY ITEM IN RED

