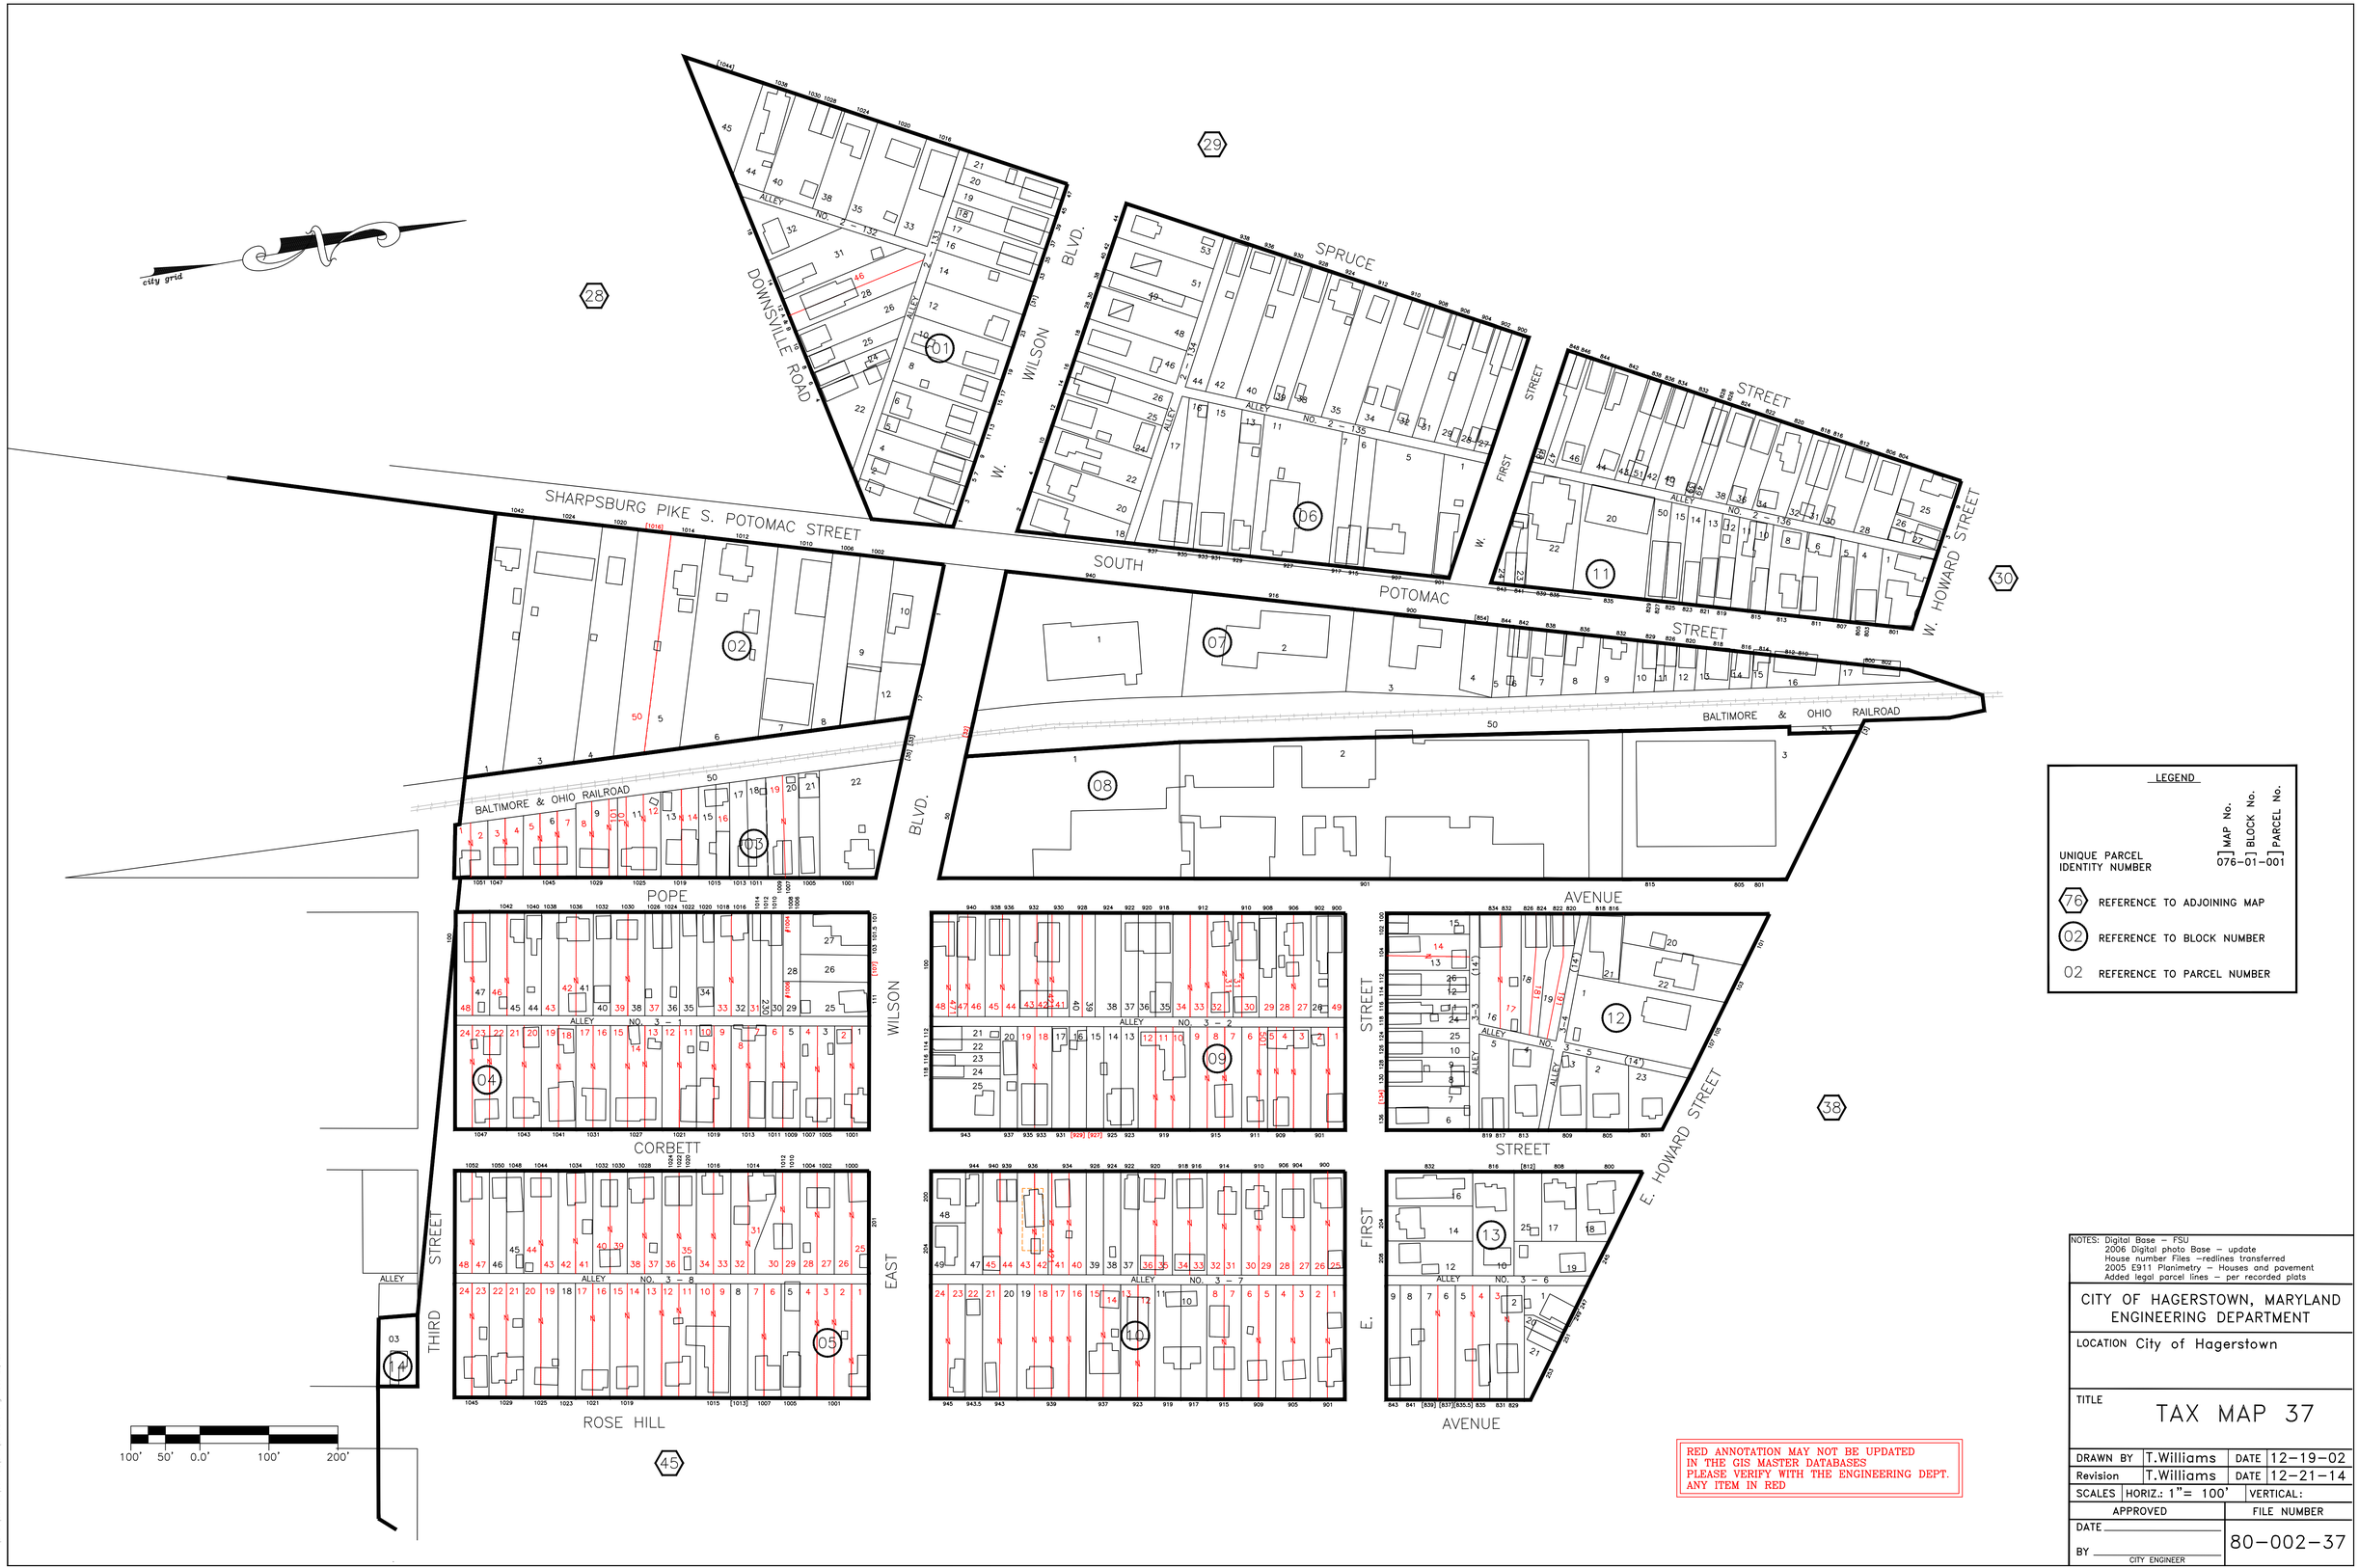

LEGEND

UNIQUE PARCEL IDENTITY NUMBER — MAP No. 076 – BLOCK No. 01 – PARCEL No. 001

76 REFERENCE TO ADJOINING MAP

02 REFERENCE TO BLOCK NUMBER

02 REFERENCE TO PARCEL NUMBER

RED ANNOTATION MAY NOT BE UPDATED IN THE GIS MASTER DATABASES PLEASE VERIFY WITH THE ENGINEERING DEPT. ANY ITEM IN RED

NOTES: Digital Base – FSU
2006 Digital photo Base – update
House number Files –redlines transferred
2005 E911 Planimetry – Houses and pavement
Added legal parcel lines – per recorded plats

CITY OF HAGERSTOWN, MARYLAND
ENGINEERING DEPARTMENT

LOCATION City of Hagerstown

TITLE TAX MAP 37

DRAWN BY	T.Williams	DATE	12–19–02
Revision	T.Williams	DATE	12–21–14
SCALES	HORIZ.: 1"= 100'	VERTICAL:	
APPROVED		FILE NUMBER	
DATE		80–002–37	
BY	CITY ENGINEER		