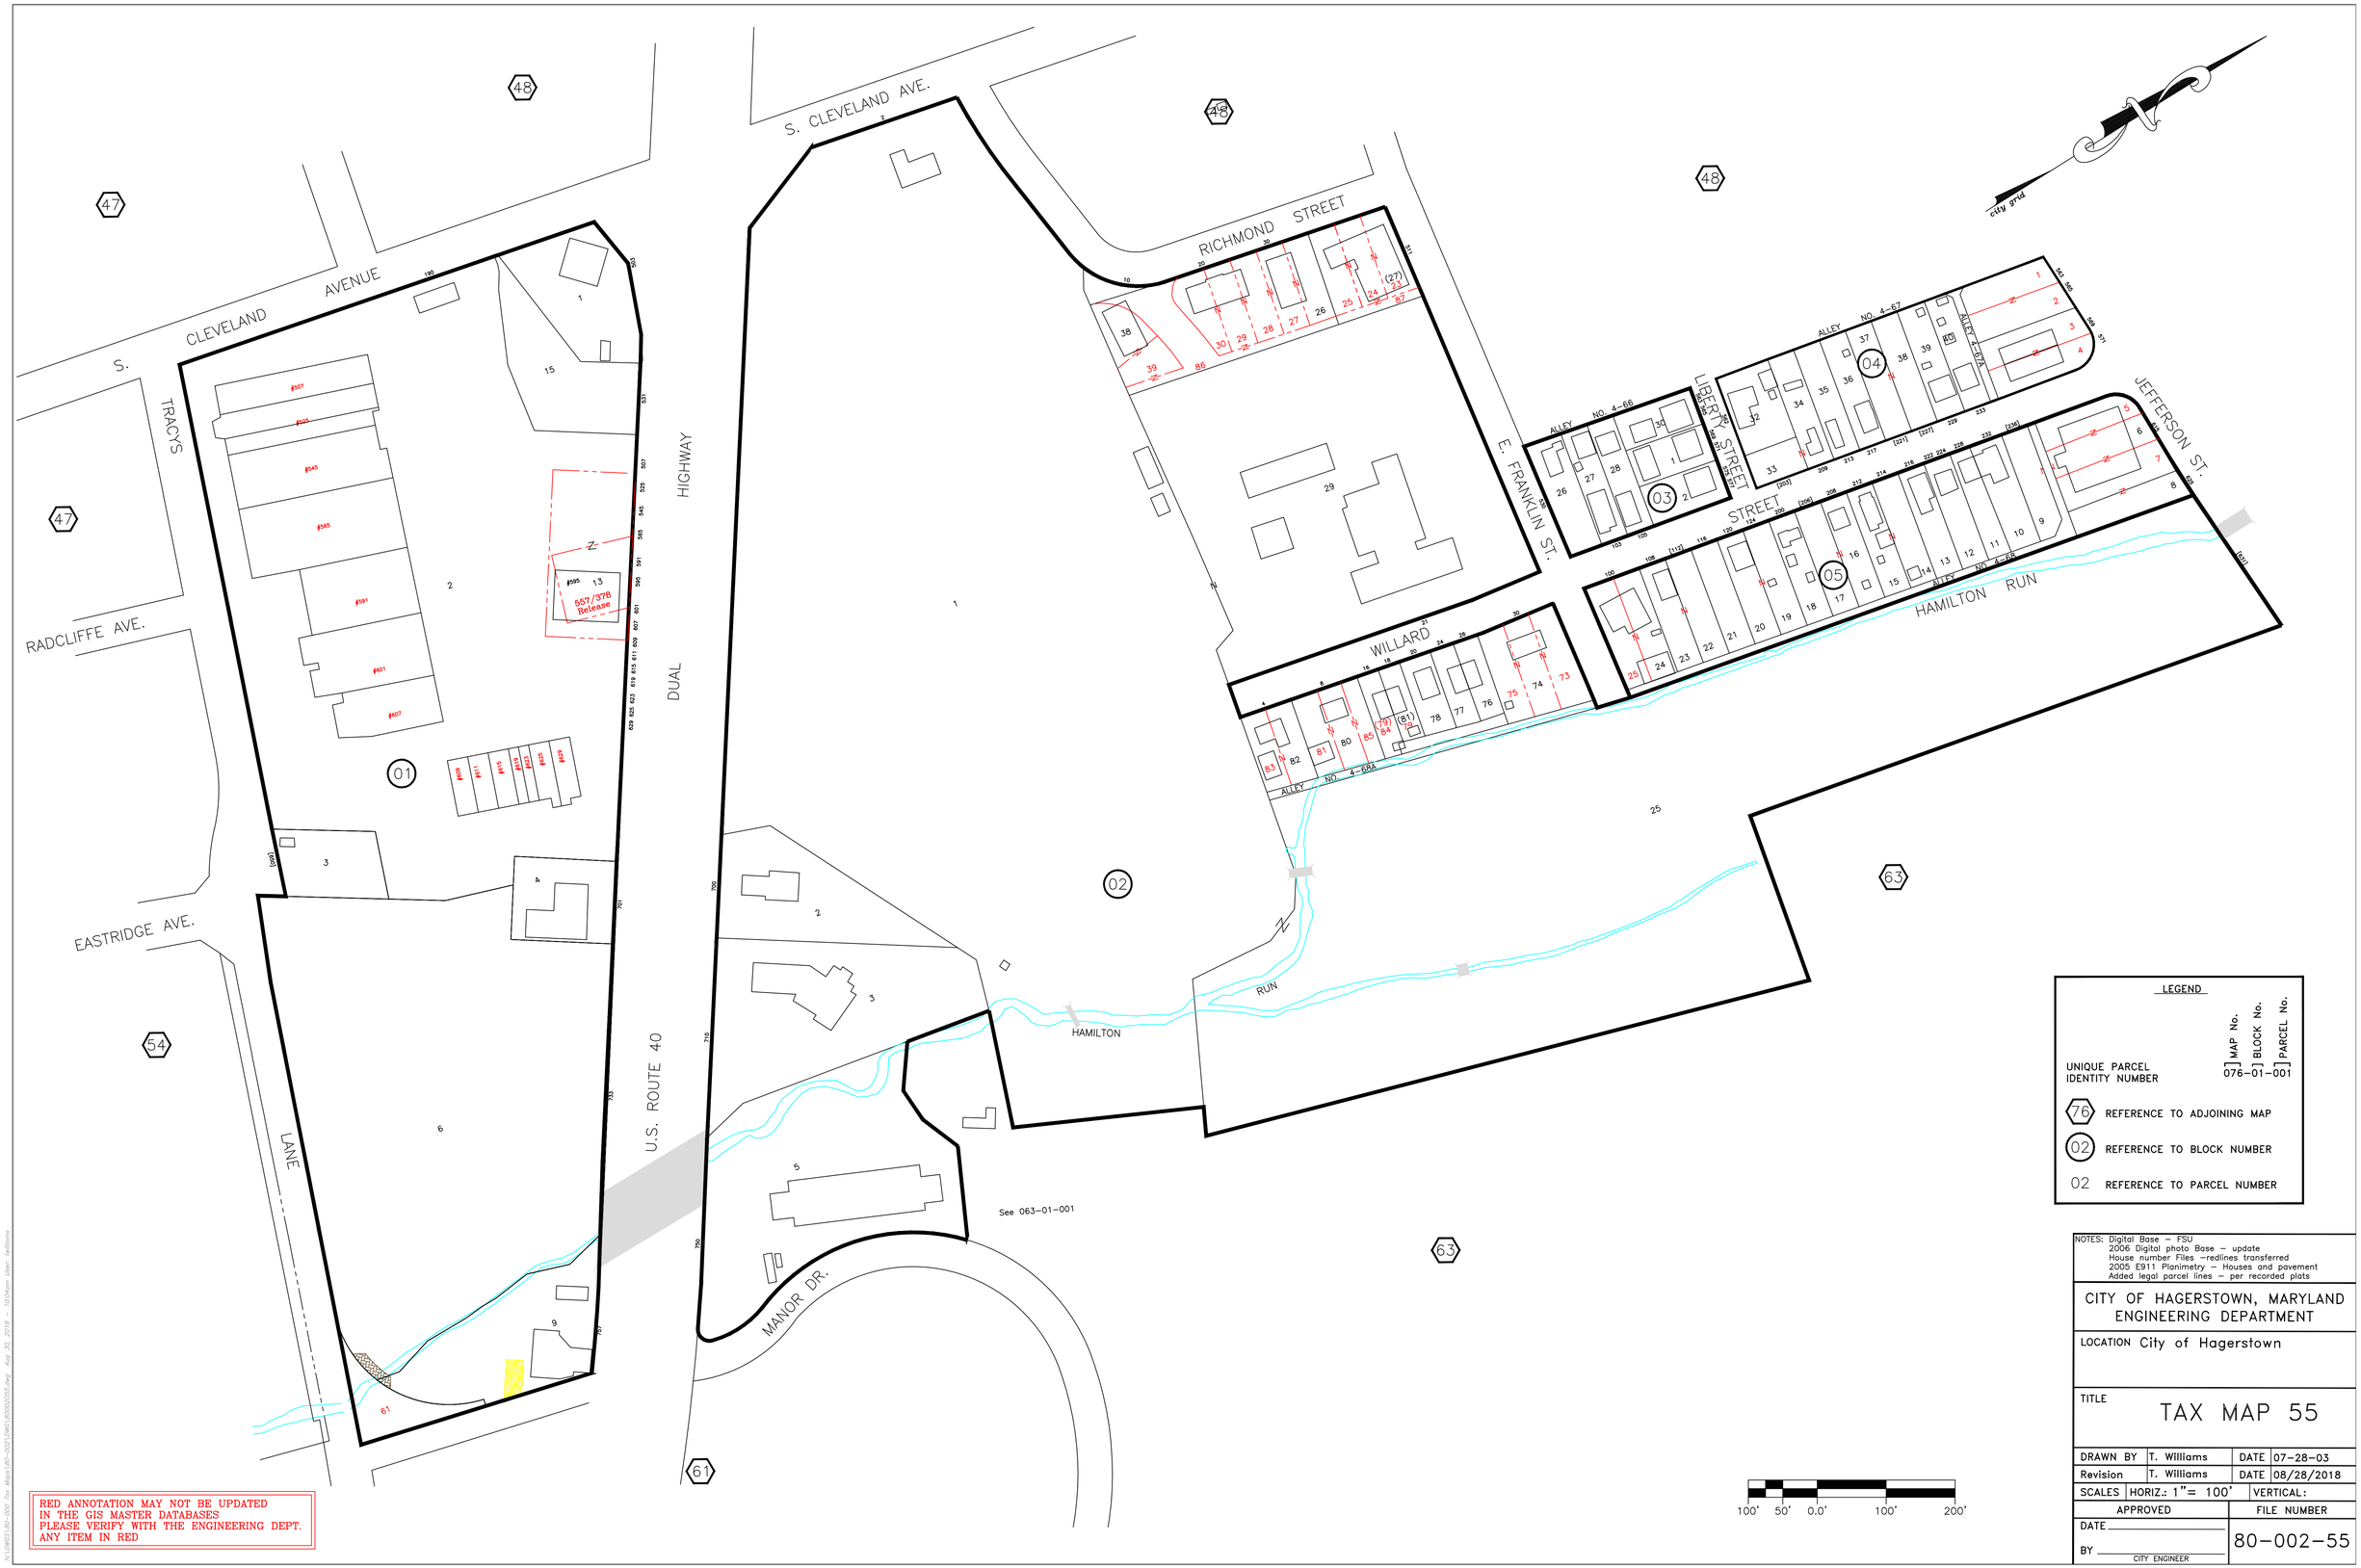
S. CLEVELAND AVENUE
S. CLEVELAND AVE.
RICHMOND STREET
E. FRANKLIN ST.
LIBERTY STREET
JEFFERSON ST.
WILLARD STREET
HAMILTON RUN
TRACYS LANE
RADCLIFFE AVE.
EASTRIDGE AVE.
DUAL HIGHWAY
U.S. ROUTE 40
MANOR DR.
HAMILTON RUN
557/378 Release
See 063-01-001
city grid
100' 50' 0.0' 100' 200'
LEGEND
UNIQUE PARCEL IDENTITY NUMBER
MAP No. BLOCK No. PARCEL No.
076-01-001
76 REFERENCE TO ADJOINING MAP
02 REFERENCE TO BLOCK NUMBER
02 REFERENCE TO PARCEL NUMBER
NOTES: Digital Base – FSU
2006 Digital photo Base – update
House number Files –redlines transferred
2005 E911 Planimetry – Houses and pavement
Added legal parcel lines – per recorded plats
CITY OF HAGERSTOWN, MARYLAND
ENGINEERING DEPARTMENT
LOCATION City of Hagerstown
TITLE TAX MAP 55
DRAWN BY T. Williams DATE 07-28-03
Revision T. Williams DATE 08/28/2018
SCALES HORIZ.: 1"= 100' VERTICAL:
APPROVED
FILE NUMBER
DATE
BY
CITY ENGINEER
80-002-55
RED ANNOTATION MAY NOT BE UPDATED
IN THE GIS MASTER DATABASES
PLEASE VERIFY WITH THE ENGINEERING DEPT.
ANY ITEM IN RED