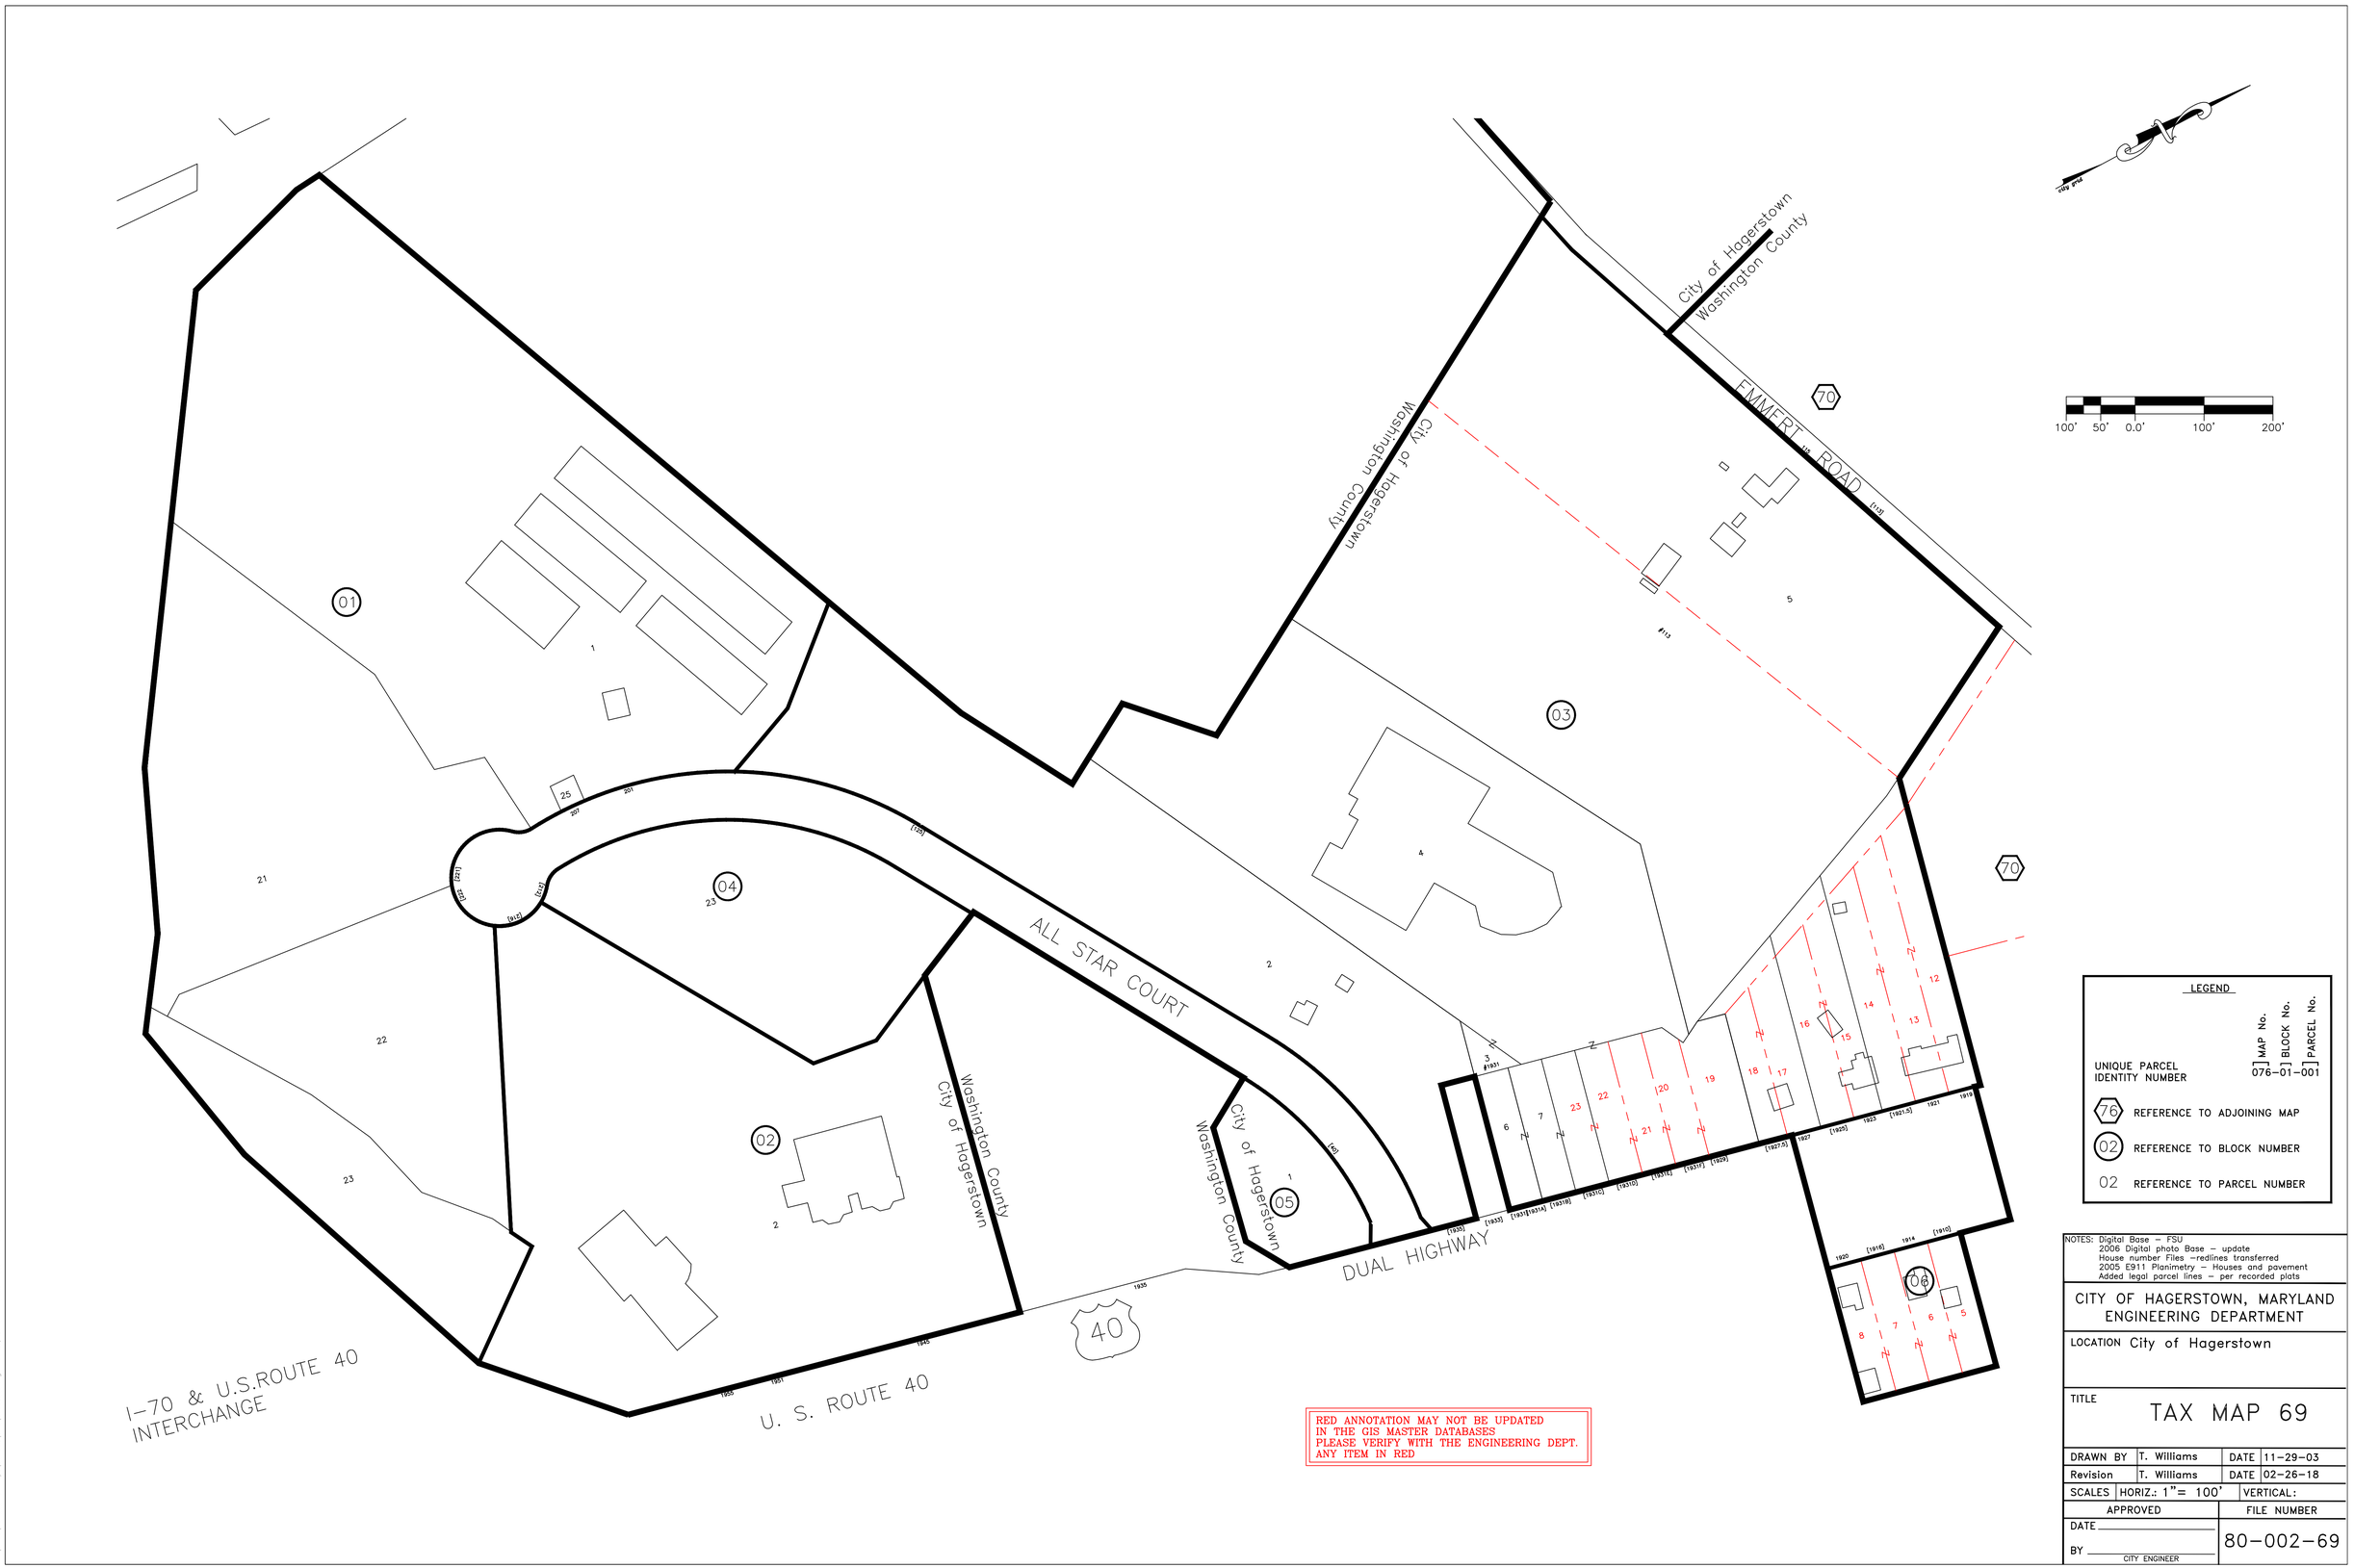
City of Hagerstown
Washington County
EMMERT ROAD
70
City of Hagerstown
Washington County
01
03
04
02
05
06
ALL STAR COURT
Washington County
City of Hagerstown
City of Hagerstown
Washington County
DUAL HIGHWAY
40
I-70 & U.S.ROUTE 40
INTERCHANGE
U. S. ROUTE 40
100' 50' 0.0' 100' 200'
LEGEND
UNIQUE PARCEL IDENTITY NUMBER
MAP No. BLOCK No. PARCEL No.
076-01-001
76 REFERENCE TO ADJOINING MAP
02 REFERENCE TO BLOCK NUMBER
02 REFERENCE TO PARCEL NUMBER
RED ANNOTATION MAY NOT BE UPDATED
IN THE GIS MASTER DATABASES
PLEASE VERIFY WITH THE ENGINEERING DEPT.
ANY ITEM IN RED
NOTES: Digital Base – FSU
2006 Digital photo Base – update
House number Files –redlines transferred
2005 E911 Planimetry – Houses and pavement
Added legal parcel lines – per recorded plats
CITY OF HAGERSTOWN, MARYLAND
ENGINEERING DEPARTMENT
LOCATION City of Hagerstown
TITLE
TAX MAP 69
DRAWN BY T. Williams DATE 11-29-03
Revision T. Williams DATE 02-26-18
SCALES HORIZ.: 1"= 100' VERTICAL:
APPROVED
FILE NUMBER
DATE
BY
CITY ENGINEER
80-002-69