

Washington County
City of Hagerstown

Washington County
City of Hagerstown

PAUL SMITH BOULEVARD

ELL ROAD


U. S. ROUTE 40

DUAL HIGHWAY

E-911 LEGEND	
	BUILDING FOOTPRINTS 4-2005
	ROAD CARTWAY 4-2005
	PARKING AREA 4-2005

Provided by: E911 Numbers Board,
Spring 2005 Flight.

LEGEND	
	UNIQUE PARCEL IDENTITY NUMBER
	MAP No.
	BLOCK No.
	PARCEL No.
	REFERENCE TO ADJOINING MAP
	REFERENCE TO BLOCK NUMBER
	REFERENCE TO PARCEL NUMBER

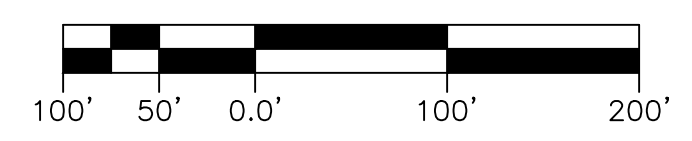

NOTES: Digital Base - FSU
2006 Digital photo Base - update
House number Files -redlines transferred
2005 E911 Planimetry - Houses and pavement
Added legal parcel lines - per recorded plats

CITY OF HAGERSTOWN, MARYLAND ENGINEERING DEPARTMENT	
LOCATION City of Hagerstown	
TITLE TAX MAP 71	
DRAWN BY T. Williams	DATE 12-20-03
Revision N. McKenny	DATE 09-05-08
SCALES HORIZ.: 1"= 100'	VERTICAL:
APPROVED	FILE NUMBER
DATE	80-002-71
BY CITY ENGINEER	


RED ANNOTATION MAY NOT BE UPDATED
IN THE GIS MASTER DATABASES
PLEASE VERIFY WITH THE ENGINEERING DEPT.
ANY ITEM IN RED